


Section 32 Township 31 Range 1W

Well No. #2 Frankum

Company Bridgeport  
Miscellaneous

NORTH

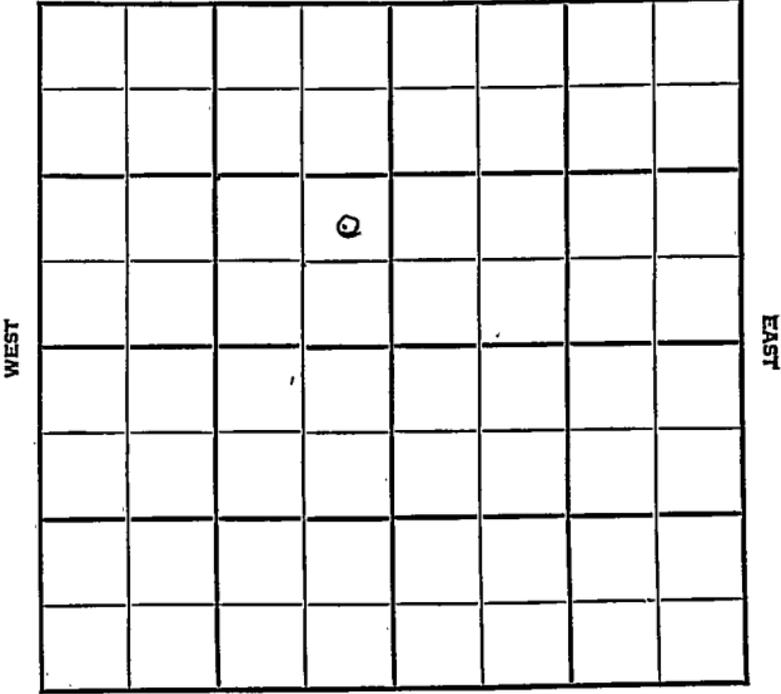

SOUTH

Sec. 32 Twp. 31 R. 1W

Well No. #2 Frankum Farm

Bridgeport Company


Misc.

           Ft. from N. Line

990 Ft. from S. Line

330 Ft. from E. Line

           Ft. from W. Line

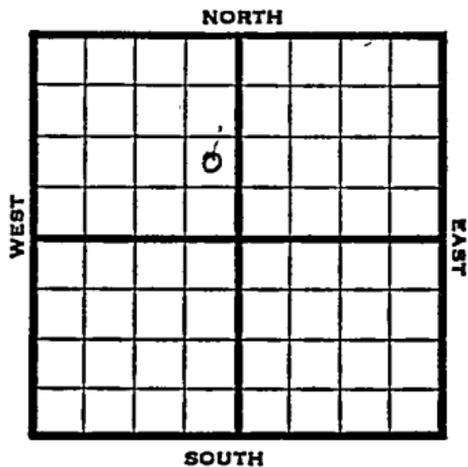

NE SE NW

1948

Elev. 1246' REPORT

4/14

8" @ 135'

Drlg. 893'

4/21

Drlg. 3605'

4/28

Lansing 3028'

Mississippi 3653'

TD 3656'

5" @ 3655'

RUST

5/5

"

5/12

TD 3681'

Swb. 30½ bbls. oil 16 hrs.

5/19

"

5/26

"

6/1

3000 acid.

6/9

Miss. 3653'

5" @ 3655'

3000 acid

Pump 68 oil / 10% W

38.0 Gr.

TD 3681'

Comp.

**COMPLETED**

Map No. \_\_\_\_\_ Sec. 32 Twp. 31 R. 1W

Well No. 2 Frankum

Bridgeport Company

**FIRST REPORT** Contractor

NE SE NW

SECTION PLAT

	o		

\_\_\_\_\_ Ft. from N. Line

990 Ft. from S. Line

330 Ft. from E. Line

\_\_\_\_\_ Ft. from W. Line

Sumner County

Location \_\_\_\_\_

Rig up \_\_\_\_\_

Drilling and Remarks:

8" @ 135

drlg. 893

RECORD

Cased \_\_\_\_\_ in., \_\_\_\_\_ ft.

Sand \_\_\_\_\_

Gas \_\_\_\_\_

Oil \_\_\_\_\_

Total Depth \_\_\_\_\_

PRODUCTION

1st 24 hrs. Nat. \_\_\_\_\_

1st 24 hrs. after shot \_\_\_\_\_

Gas \_\_\_\_\_ Cu. Ft.

Dry Hole \_\_\_\_\_

Abandoned \_\_\_\_\_

Date

APR 14 1948

19

S. J. LEWIS

Scout

