


Section 32 Township 31 Range 1-W

Well No. 7 - Frankum

Company Stelbar

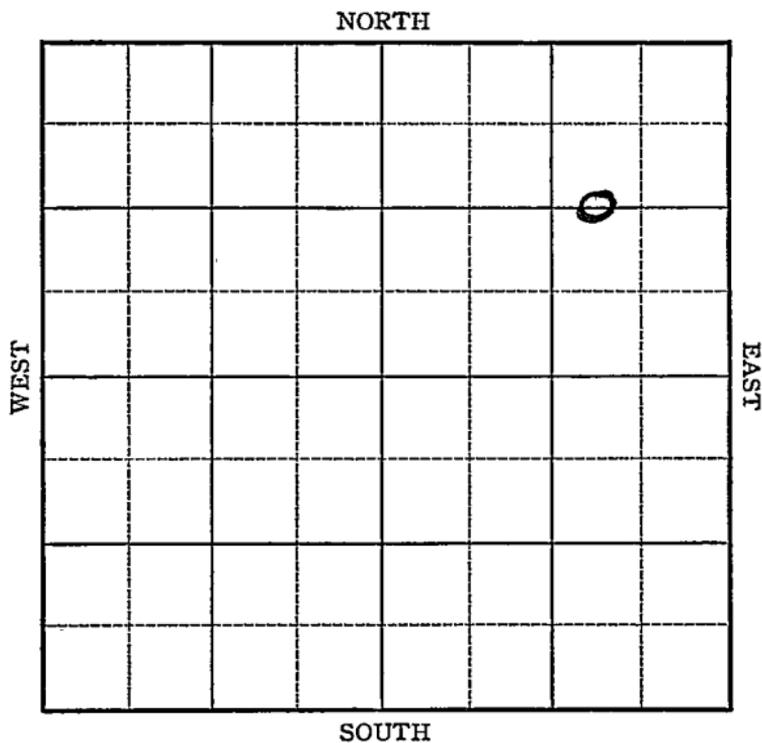


Sec. 32 Twp. 31 R. 1WWell No. #7 Frankum FarmStelbar Company1320 Ft. from N. Line

_____ Ft. from S. Line

990 Ft. from E. Line

_____ Ft. from W. Line

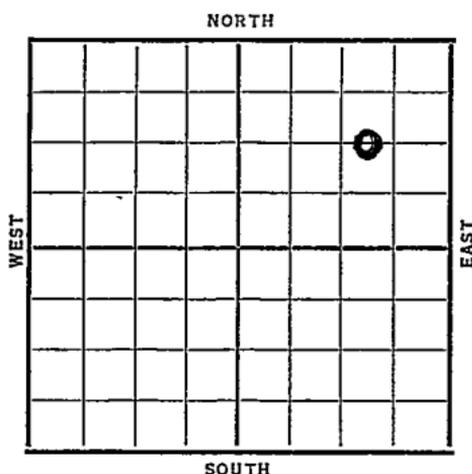

| Date | REPORT |
|-------|----------------------------|
| 1937 | |
| 8/25 | Material. |
| 9/3 | " |
| 9/10 | 10" @ 330'. Drlg. 1150'. j |
| 9/17 | Drlg. 2434'. |
| 9/24 | Drlg. 3526'. |
| 10/2 | Chat 3650'. T.D. 3651'. |
| | 7" @ 3650'. RUST. No shows |
| | reported. |
| 10/8 | T.D. 3696' acidizing. |
| | |
| 10/13 | 7" @ 3650'. |
| | Chat 3650'. |
| | T.D. 3696'. |
| | Potential 360 bbls. flow. |
| | COMPLETED |
| | |
| | |
| | |
| | |

Summer

Map No. _____ Sec. 32 Twp. 31 R. 1W

Well No. 7 - Frankum

Stelbar Company

FIRST REPORT

Contractor _____

C WL E² N

1320 Ft. from N. Line

_____ Ft. from S. Line

990 Ft. from E. Line

_____ Ft. from W. Line

SECTION PLAT

| | | | |
|--|--|--|---|
| | | | |
| | | | ○ |
| | | | |
| | | | |

Location _____

Rig up _____

Drilling and Remarks:

Ma.

RECORD

Cased _____ in., _____ ft.

Sand _____

Gas _____

Oil _____

Total Depth _____

PRODUCTION

1st 24 hrs. Nat. _____

1st 24 hrs. after shot _____

Gas _____ Cu. Ft.

Dry Hole _____

Abandoned _____

Date

AUG 25 1937 19

H. D. Hatfield Scout

Map No. 31 Sec. 32 Twp. 31 R. 1WWell No. 7 FrankumStelbar Company

Contractor

COMPLETEDC W L E $\frac{1}{2}$ NE**SECTION PLAT**

| | | | |
|--|--|--|---|
| | | | |
| | | | 0 |
| | | | |
| | | | |

1320 Ft. from N. Line

_____ Ft. from S. Line

990 Ft. from E. Line

_____ Ft. from W. Line

Location _____

Rig up _____

Drilling and Remarks:

POT - 360
Flow

RECORDCased 7 in., 3650 ft.Sand CHAT 3650

Gas _____

Oil _____

Total Depth 3696**PRODUCTION**

1st 24 hrs. Nat. _____

1st 24 hrs. after shot _____

Gas _____ Cu. Ft.

Dry Hole _____

Abandoned _____

Date

OCT 13 1937 19 E. D. Hatfield Scout