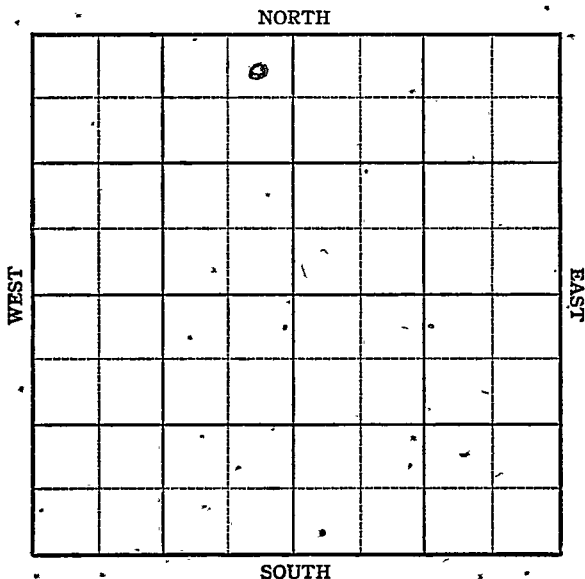


KANSAS

Sumner county

Section - 32 Township - 31 Range - 1-WWell No. #1, FrankumCompany Kiowa Drlg. etal

KANSAS


Sumner County

Sec. 32 Twp. 31 R. 1WWell No. 1 Frankum FarmKiowa Drlg. Etal Company

Miscellaneous

330 Ft. from N. Line Ft. from S. Line330 Ft. from E. Line330 Ft. from W. Line

NE NW

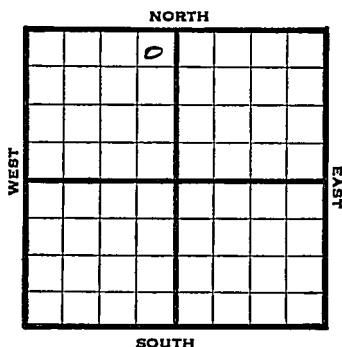1947 REPORT

Elev. 1239'

1/2 Drilling 1080'

1/8 8" @ 342'
Drlg 3175'1/15 TD 3645'
5" @ 3645
RUST1/22 Miss 3638'
5" @ 3645'
TD 3678'
500 Acid
Pump 40 Pot
40 Grav.**COMPLETED**

Kansas

KANSAS

Map No. 31 Sec. 32 Twp. 31 R. 1WWell No. 1 Frankum

Kiowa Drlg. etal.

Company

FIRST REPORT

Contractor

NE NW

SECTION PLAT

330 Ft. from N. Line Ft. from S. Line330 Ft. from E. Line330 Ft. from W. Line

		0	

Sumner County

Location Rig up

Drilling and Remarks:

1080

RECORD

Cased in., ft.Sand Gas Oil Total Depth

PRODUCTION

1st 24 hrs. Nat. 1st 24 hrs. after shot Gas Cu. Ft.Dry Hole Abandoned

Date

JAN 2 1947 19

S. J. LEWIS

Scout

Map No. 31 Sec. 32 Twp. 31 R. 1W

Well No. 1 Frankum

Kiowa Drlg. etal. Company

COMPLETE

Contractor

NE NW

E 11289
SECTION PLAT

330

Ft. from N. Line

Ft. from S. Line

Ft. from E. Line

330

Ft. from W. Line

	6		

Sumner County

Location

Rig up

Drilling and Remarks:

Mias 3638
5" 63645
5000 accl
Pump 40 ft
40 2 hr

RECORD

Cased _____ in., _____ ft.

Sand _____

Gas _____

Oil _____

Total Depth *3638*

PRODUCTION

1st 24 hrs. Nat. _____

1st 24 hrs. after shot _____

Gas _____ Cu. Ft. ,

Dry Hole _____

Abandoned _____

Date

JAN 22 1947 19

S. J. LEWIS

Scout