

Map No. KANSAS Sec. 32 Twp. 31 R. 1^W


Well No. 3- Frankum Farm
Shawover et al Company

_____ Ft. from N. Line

990 Ft. from S. Line

330 Ft. from E. Line

_____ Ft. from W. Line

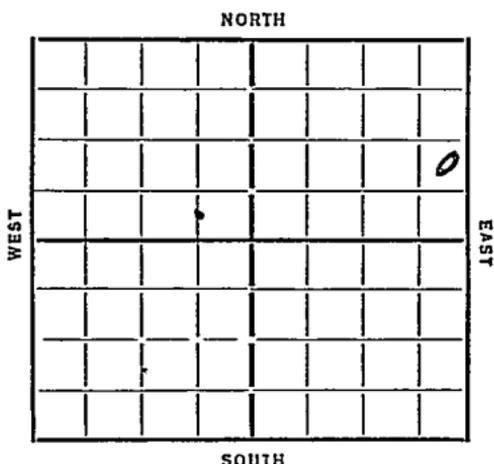

Date 1935

REPORT

5/1 Rig
5/9 dly 75
5/16 ~~_____~~
5/23 dly 2420
5/29 15@ 3380 dly 3435
6/6 Chrt 3651 6" 3653
6/13 _____
6/20 3693 487 24 hrs
 1000 acid
6/26 Top Chrt 3651
 T-17 3693
 Pump 278 Bobs

COMPLETED

Map No. _____ Sec. 33 Twp. 31 R. 1W

Well No. 3- Frankum

Shawver et al Company

Contractor

FIRST REPORTS

SECTION PLAT

			0

_____ Ft. from N. Line

990 Ft. from S. Line

330 Ft. from E. Line

_____ Ft. from W. Line

Location _____

Rig up _____

Drilling and Remarks:

Rig

RECORD

Cased _____ in., _____ ft.

Sand _____

Gas _____

Oil _____

Total Depth _____

PRODUCTION

1st 24 hrs. Nat. _____

1st 24 hrs. after shot _____

Gas _____ Cu. Ft.

Dry Hole _____

Abandoned _____

Date

5-1-35 192

ORVAL MANNSCHRECK

Scout

KANSAS

Map No. 31 Sec. 32 Twp. 31 R. 1W

Well No. 3 Frankum

Shaver Company

Contractor

CORRECTION

..... Ft. from N. Line

990 Ft. from S. Line

330 Ft. from E. Line

..... Ft. from W. Line

CORRECTION

SECTION PLAT

			0

Location Frankum

Rig up

Drilling and Remarks:

*Rig
formerly reported
as Section 33*

RECORD

Cased.....in.,ft.

Sand.....

Gas.....

Oil.....

Total Depth.....

PRODUCTION

1st 24 hrs. Nat.....

1st 24 hrs. after shot.....

Gas.....Cu. Ft.

Dry Hole.....

Abandoned.....

Date

5-2-35 192.....

ORVAL MANNSCHECK

Scout

Map No. 31 Sec. 32 Twp. 31 R. 1W

Well No. 3 Frankum

Shawver & Dal Company

Contractor

SECTION PLAT

..... Ft. from N. Line

990 Ft. from S. Line

330 Ft. from E. Line

..... Ft. from W. Line

			o

COMPLETED

Location.....

Rig up.....

Drilling and Remarks:

Top Chat 3651

Pump 275 ft

RECORD

Cased..... in., ft.

Sand.....

Gas.....

Oil.....

Total Depth... 3693

PRODUCTION

1st 24 hrs. Nat.....

1st 24 hrs. after shot.....

Gas..... Cu. Ft.

Dry Hole.....

Abandoned.....

Date

6/26/25 192.....

ORVAL MANNSCHRECK
Scout