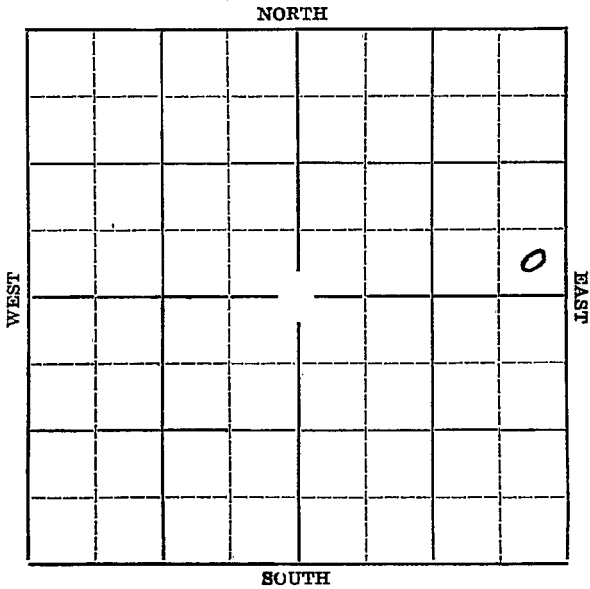


Section 32 Township 31 Range 1-WWell Number 4-FrankunCompany Stellbar Oil

Map No. Sec. 32 Twp. 31 R. 1W

Well No. #4 Franklon. Farm

Stellbar Oil.


Company

 Ft. from N. Line

330' Ft. from S. Line

330' Ft. from E. Line

 Ft. from W. Line

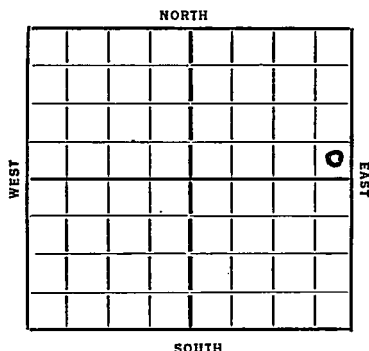

Elev. 1264

Date
1936

REPORT

5/13 Rig on ground.

5/21 Rigging up.

5/28 Drlg. 640'.

6/4 Drlg. 2560'.

6/11 Drlg. 3360'.

7/1/36-Chat 3650'.

1,000 gallons of acid.

1,000 gallons of acid.

T.D. 3680'.

Potential 648 bbls oil. Flow.

COMPLETED

KANSAS

Map No. 31 Sec. 32 Twp. 31 R. 1W

Well No. 4 Frankum

Stell for Oil Company

Contractor

SECTION PLAT

 Ft. from N. Line

330 Ft. from S. Line

330 Ft. from E. Line

 Ft. from W. Line

FIRST REPORT

RECORD

Location

Cased in., ft.

Rig up

Sand

Drilling and Remarks:

Gas

RDG

Oil

Total Depth

PRODUCTION

1st 24 hrs. Nat.

1st 24 hrs. after shot

Gas Cu. Ft.

Dry Hole

Abandoned

Date

MAY 13 1936

19

S. J. LEWIS

Scout

*Samner*Map No. 31 Sec. 32 Twp. 31 R. 11Well No. 4 FranklinStellar Oil Company

Contractor

SECTION PLAT

			0

_____ Ft. from N. Line

330 Ft. from S. Line330 Ft. from E. Line

_____ Ft. from W. Line

COMPLETED

Location _____

Rig up _____

Drilling and Remarks:

*Chas 3650**1000 acid**1000 "**Pos 64884**Flow.*

RECORD

Cased _____ in., _____ ft.

Sand _____

Gas _____

Oil _____

Total Depth 8680

PRODUCTION

1st 24 hrs. Nat. _____

1st 24 hrs. after shot _____

Gas _____ Cu. Ft.

Dry Hole _____

Abandoned _____

Date

JUL 1 1936 19

S. J. LEWIS

Scout