


Section 32 Township 31 Range 1W

Well No. 2 Markley

Company Stelbar

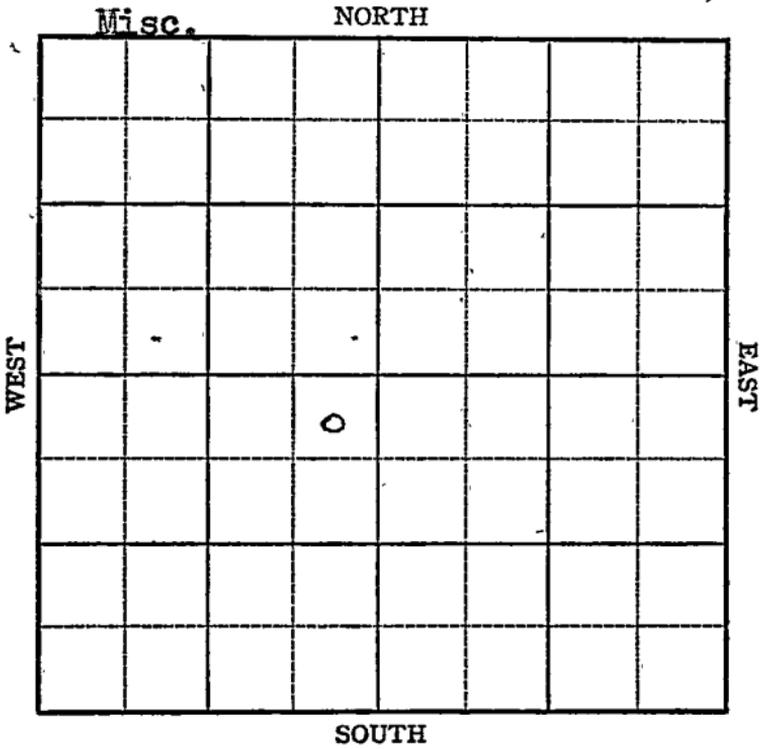

Sec. 32 Twp. 31 R. 1W

Well No. #2 ~~#1~~ Markley Farm

Stelbar Company

Miscellaneous


330 Ft. from N. Line

_____ Ft. from S. Line

330 Ft. from E. Line

_____ Ft. from W. Line

NE SW

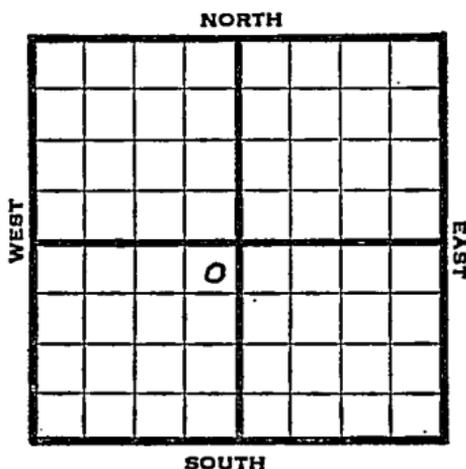

1947 Elev. 1241' REPORT

- 4/2 10" @ 140'
Drlg. 1035'
- 4/9 KC 3036'
Drlg. 3130'
- 4/15 Mississippi 3658-59' TD
5" @ 3659'
RUST
- 4/23 " "
- 4/29 " "
- 5/7 TD 3701- 5000 Acid.
- 5/14 Miss 3658'
5" @ 3659'
5000 Acid
Pump 15 Pot
40.0 Gr.
TD 3701'

COMPLETED

Map No. K-21 Sec. 32 Twp. 31 R. 1W

Well No. 1 Markley

Stelbar Company
FIRST REPORT

Contractor

NE SW


SECTION PLAT

330 Ft. from N. Line

_____ Ft. from S. Line

330 Ft. from E. Line

_____ Ft. from W. Line

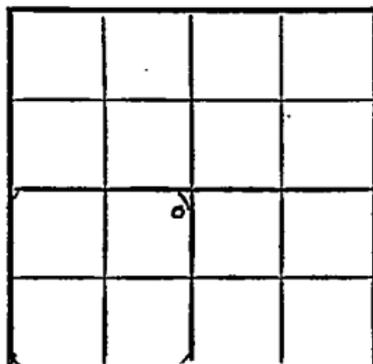

Summer County

Location _____

Rig up _____

Drilling and Remarks:

10" @ 140
drlg. 1035

RECORD

Cased _____ in., _____ ft.

Sand _____

Gas _____

Oil _____

Total Depth _____

PRODUCTION

1st 24 hrs. Nat. _____

1st 24 hrs. after shot _____

Gas _____ Cu. Ft.

Dry Hole _____

Abandoned _____

Date

APR 2 1947 19

S. J. LEWIS Scout

Map No. K31 Sec. 32 Twp. 31 R. 1W

Well No. 2 Markley

Stelbar Company

CORRECTION Contractor

NE SW

SECTION PLAT

330 Ft. from N. Line

_____ Ft. from S. Line

330 Ft. from E. Line

_____ Ft. from W. Line

	o		

Sumner County

Location _____

Rig up _____

Drilling and Remarks:

Reported
#1 Markley

RECORD

Cased _____ in., _____ ft.

Sand _____

Gas _____

Oil _____

Total Depth _____

PRODUCTION

1st 24 hrs. Nat. _____

1st 24 hrs. after shot _____

Gas _____ Cu. Ft.

Dry Hole _____

Abandoned _____

Date

APR 9 1947

19

S. J. LEWIS

Scout

Map No. A-31 Sec. 32 Twp. 31 R. 1W

Well No. 2 Markley

Stelbar Company

COMPLETE

Contractor

NE SW

E11241
SECTION PLAT

330 Ft. from N. Line

_____ Ft. from S. Line

330 Ft. from E. Line

_____ Ft. from W. Line

Sumner County

Location _____

Rig up _____

Drilling and Remarks:



RECORD

Cased _____ in., _____ ft.

Sand _____

Gas _____

Oil _____


PRODUCTION

1st 24 hrs. Nat. _____

1st 24 hrs. after shot _____

Gas _____ Cu. Ft.

Dry Hole _____

Abandoned _____

Date

MAY 14 1947 19

S. J. LEWIS Scout