


Summer

KANSAS
Range 1-W

Section 32 Township 31

Well Number 1 J.A. Markley "B"

Company Vickers Pet

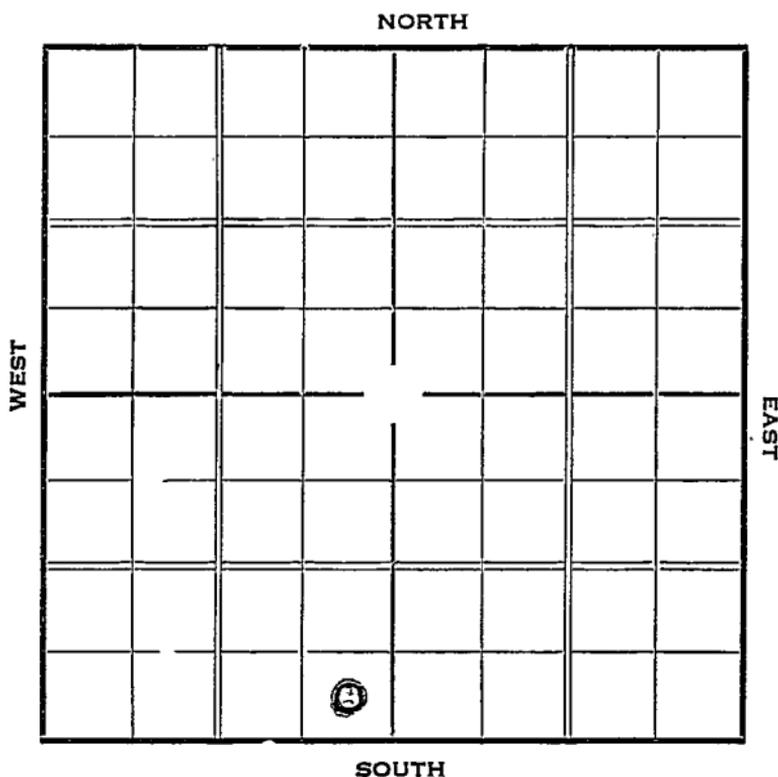

Map No. _____ Sec. 32 Twp. 31 R. 1-W

Well No. #1 J. A. Markley "B" Farm _____

Vickers Pet. Company _____


_____ Ft. from N. Line

330 Ft. from S. Line

330 Ft. from E. Line

_____ Ft. from W. Line

Elv. 1239

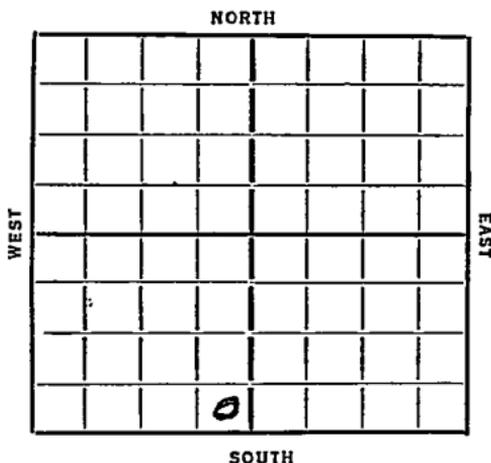

Date
1936

REPORT

- 12/16 Surface hole.
- 12/24 12 1/2" @ 325'. Drlg. 450'.
- 12/29 Drlg. 2502'.
- 1937
- 1/7 Drlg. 3330'.
- 1/14 Chat 3666'. 7" @ 3668'. WOC
- 1/21 " " " " " "
- 1/28 T. D. 3696'. Flowed 100
bbls. 1st hr. Shut in for
Tanks.
- 2/4 1000 acid. No test.
- 2/11 T.D. 3698'. Pump 175 oil 25 wtr.
- 2/18 " " " " " "
- 2/26 " " " " " "
- 3/4 " " " " " "

OVER

1937

3/10 Chat 3670'.

T. D. 3701'.

1000 acid.

Potential 169 oil, 10 water.

COMPLETED

KANSAS

Map No. 31 Sec. 32 Twp. 31 R. 1W.Well No. J. A. Markey "B"Pickers Pe & J Company

Contractor

SECTION PLAT

_____ Ft. from N. Line

330 Ft. from S. Line330 Ft. from E. Line

_____ Ft. from W. Line

FIRST REPORT

Location _____

Rig up _____

Drilling and Remarks:

Surface hole

RECORD

Cased _____ in., _____ ft.

Sand _____

Gas _____

Oil _____

Total Depth _____

PRODUCTION

1st 24 hrs. Nat. _____

1st 24 hrs. after shot _____

Gas _____ Cu. Ft.

Dry Hole _____

Abandoned _____


Date

DEC 16 1936 19

S. J. LEWIS Scout

at 2:20

PH. 10000 40 3 20 Scarborough V

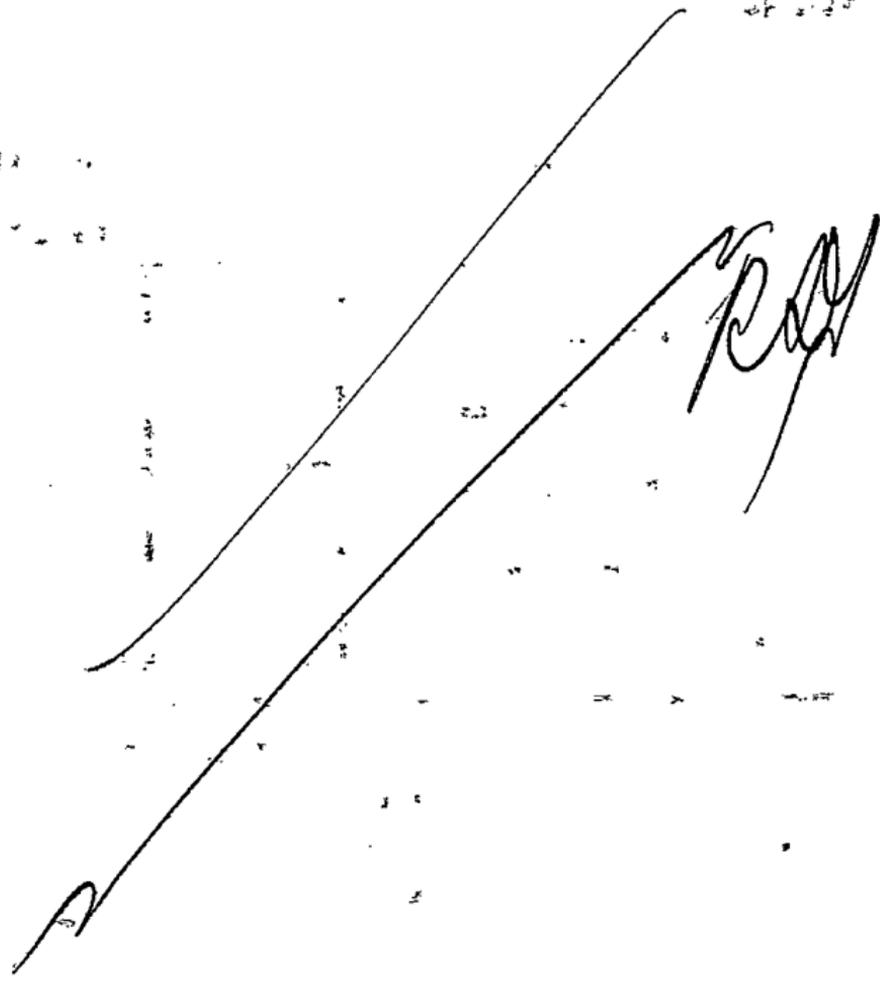

Returned
Cards	<i>Paul</i>
Tracing	<i>J.M.</i>
France Map
Scarborough R.S.
Moody Map
Scarborough FT
Moody Ph

KANSAS

Map No. 31 Sec. 32 Twp. 31 R. 1WWell No. 1. J. A. Markley BVickers P & T Company

Contractor

SECTION PLAT

_____ Ft. from N. Line

830 Ft. from S. Line830 Ft. from E. Line

_____ Ft. from W. Line

COMPLETED

RECORD

Location _____

Cased _____ in., _____ ft.

Rig up _____

Sand _____

Drilling and Remarks:

Gas _____

Ok at 3670

Oil _____

1000 acidTotal Depth 8701Potential

PRODUCTION

169 oil 10 water

1st 24 hrs. Nat. _____

1st 24 hrs. after shot _____

Gas _____ Cu. Ft.

Dry Hole _____

Abandoned _____

Date

MAR 10 1937 19

S. J. LEWIS Scout

Paul

Returned	_____
Cards	<i>Paul</i>
Tracing	<i>Joe</i>
France Map	_____
Scarborough Map	<i>AS</i>
Moody Map	_____
Scarborough Plat Book	_____
Moody Plat Book	_____