

KANSAS


FORM 51 IOM 12-46 PETROL

Summer

Section 32 Township 31 Range 1-W

Well No. #1 Murphy

Company Kiowa Drlg

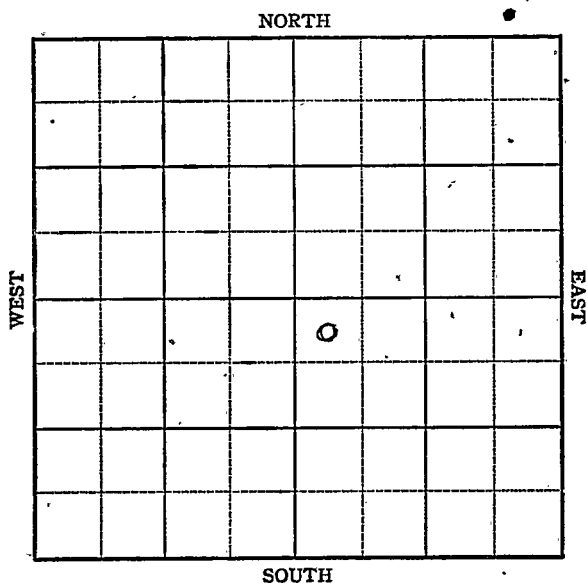

Sec. 32 Twp. 31 R. 1-W

Well No. 1 Murphy Farm
Kiowa Drlg Company


NW SE

330 Ft. from N. Line

 Ft. from S. Line

 Ft. from E. Line

330 Ft. from W. Line

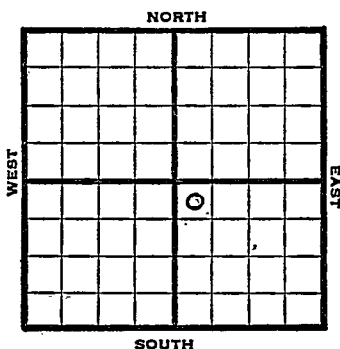

Sumner

1947 1238 REPORT

2-12 Location

2/19 8" @ 345'
Drlg 3100'


2/26 Miss 3653'-57
TD 3657'
5" @ 3654'
RUST

3/12 Miss 3653'
5" @ 3654
5000 Acid
Pump 60 Pot
Grav. 39
TD 3700'

COMPLETED

Map No. 31 Sec. 32 ~~Kansas~~ Twp. 31 R. 1WWell No. 1 MurphyKiowa Drlg. Company

Contractor

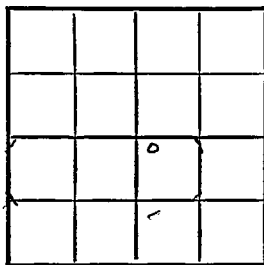
NW SE **FIRST REPORT****SECTION PLAT**330 Ft. from N. Line Ft. from S. Line Ft. from E. Line330 Ft. from W. LineSumner CountyLocation XRig up

Drilling and Remarks:

RECORDCased in, ft.Sand Gas Oil Total Depth **PRODUCTION**1st 24 hrs. Nat. 1st 24 hrs. after shot Gas Cu. Ft.Dry Hole Abandoned

Date

FEB 12 194719S. J. LEWIS Scout

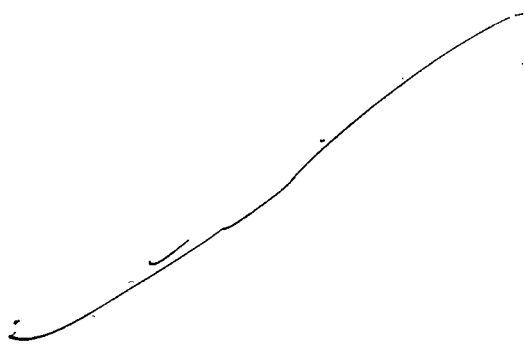

Misc. Small Maps	<i>[initials]</i>
Cards	<i>[initials]</i>
Tracing	<i>[initials]</i>
France Map	<i>[initials]</i>
Scarborough Map	<i>[initials]</i>
Pierce Map	<i>[initials]</i>
Geological Dept.	
Pierce Plat Book	

Map No. 31 Sec. 32 Twp. 31 R. 1W

Well No. 1 Murphy

Kiowa Drlg. Company

COMPLETE Contractor

NW SE

E 1, 1238

SECTION PLAT

330 Ft. from N. Line

 Ft. from S. Line

 Ft. from E. Line

330 Ft. from W. Line

		△	

Sumner County

Location

Rig up

Drilling and Remarks:

Misc 2653
5" 2654
5000 cu ft
Pump 60 psi

29° 1/2

RECORD

Cased in., ft.

Sand

Gas

Oil

Total Depth 3700

PRODUCTION

1st 24 hrs. Nat.

1st 24 hrs. after shot

Gas Cu. Ft.

Dry Hole

Abandoned

Date

MAR 1 2 1947 19

S. J. LEWIS Scout

Misc. Small Maps

Cards

Tracing

France Map

Scarborough Map

Pierce Map

Ceological Dept.

Pierre Plat