


Section 32 Township 31 Range 1W

Well No. #1 Humbert

Company Eckland Drlg.

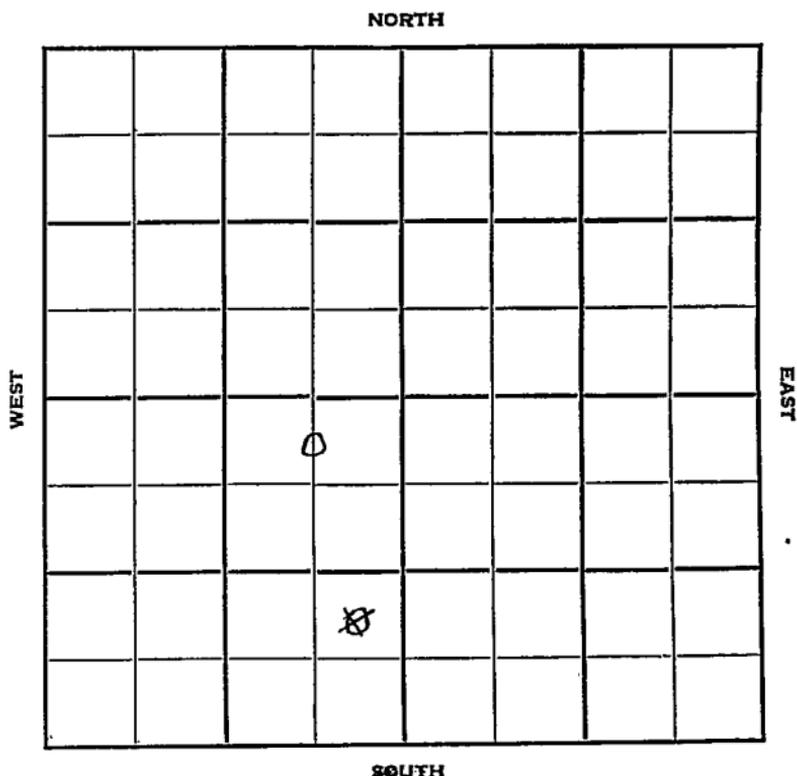

Sumner

KANSAS

Sec. 32 Twp. 31 R. 1 W

Well No. # 1 Humbert Farm

Eckland Drilling Company

Contractor


Wellington Pool

330 Ft. from N. Line

~~990~~ Ft. from S. Line

660
330 Ft. from E. Line

_____ Ft. from W. Line

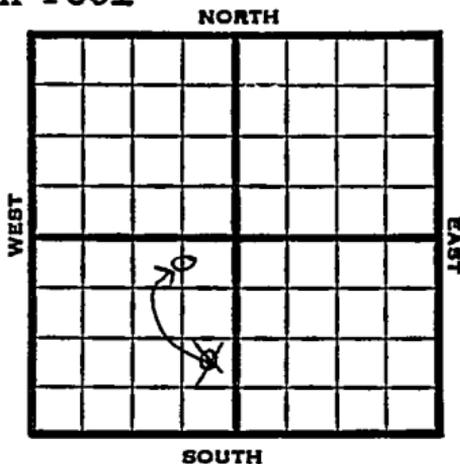

~~NE SE SW~~

CNL NESW

1951

Elev. 1245' REPORT

6/13

Location

10/31

Spud 8-4-51
 Oil Well TD 3704
 8" @ 122
 Lans. 3055 Miss 3663-66
 4 1/2" @ 3665 TD 3704
 PB 3689 4000 A
 S/1 boph 16 hr. Comp. 9 bopd

COMPLETED

County Sumner State Kansas

Sec. 32 (Blk. Twp.) 31 (Sur. Rge.) IV Map No.

Operator Eckland Drilling

Well No. 1 Farm Humbert

Elev. _____ Location NE SE SW

990 Ft. From S Line SW

330 Ft. From E Line Quarter

1st. Report JUN 13 1951

Completion _____

Remarks _____

Spudding Date _____

Drlg. Data _____

Location Wellington Pool

J. E. TYRA

Kansas

Map No. _____ Sec. 32 Twp. 31 R. 1W

Well No. 1 Humbert

Eckland Drig. Company

~~CORRECTION~~ Contractor

C N L NE SW


SECTION PLAT

330 Ft. from N. Line

_____ Ft. from S. Line

660 Ft. from E. Line

_____ Ft. from W. Line

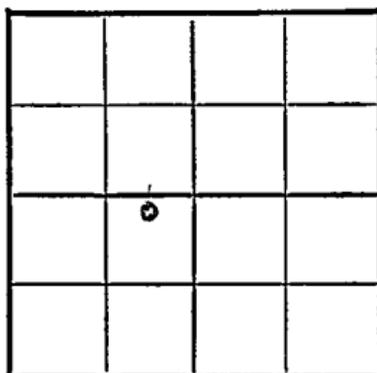

Sumner County

Location _____

Rig up _____

Drilling and Remarks: _____

Reported

NE SE SW

RECORD

Cased _____ in., _____ ft.

Sand _____

Gas _____

Oil _____

Total Depth _____

PRODUCTION

1st 24 hrs. Nat. _____

1st 24 hrs. after shot _____

Gas _____ Cu. Ft.

Dry Hole _____

Abandoned _____

Date

AUG 1 1951 19

J. E. TYRA Scout


County Sumner State Kansas

Sec. 32 (Blk. 31) (Sur. Rge.) 1W Map No.

Operator Hekland Drlg. Parter + Kruse

Well No. 1 Farm Humbert

Elev. 1245 Location C N L NE SW

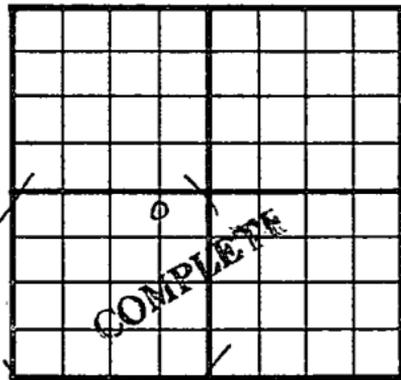

330 Ft. From N Line SW

660 Ft. From E Line Quarter

1st. Report

Completion OCT 31 1951

Remarks Wellington Pool

Spudding Date 8-4-51

Drlg. Data Oil well TD 3704

8" @ 122 Lans. 3055 Miss. 3663-66

4 1/2" @ 3665 TD 3704 PB 3689 4000 A

S/ 1 boph 16 hr. Comp. 9 bopd