


Sumner

Section 32 Township 31 Range 1-W

Well Number #3-Murphy

Company Slick, Pryor & Lockhart

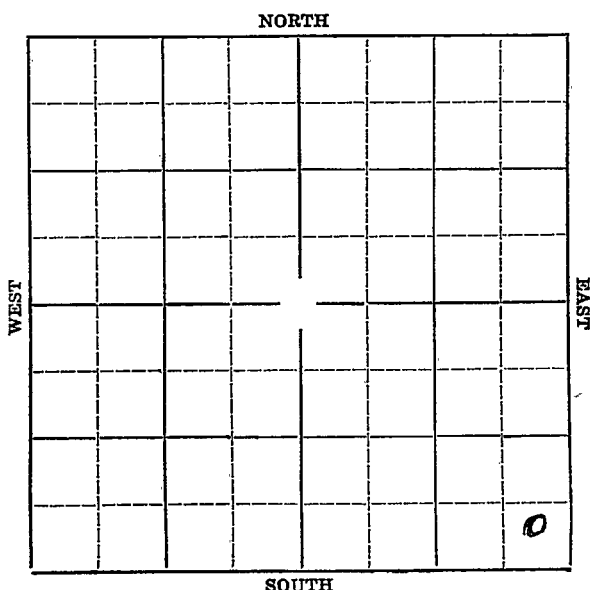

KANSAS

Map No. 31 Sec. 32 Twp. 9/ R. 1WWell No. 3 MurphyCliff P. & J. L. & Co. Company

Contractor

SECTION PLAT

 Ft. from N. Line330 Ft. from S. Line330 Ft. from E. Line Ft. from W. Line

FIRST REPORT

Location ✓Rig up

Drilling and Remarks:

RECORD

Cased in., ft.Sand Gas Oil Total Depth

PRODUCTION

1st 24 hrs. Nat. 1st 24 hrs. after shot Gas Cu. Ft.Dry Hole Abandoned

Date

AUG 19 1936

19

S. J. LEWIS

Scout

KANSAS

Map No. 31 Sec. 32 Twp. 31 R. 1WWell No. 3 MurphyClick, Pryor & Lockhart Company

Contractor

SECTION PLAT

			0

_____ Ft. from N. Line

330 Ft. from S. Line330 Ft. from E. Line

_____ Ft. from W. Line

COMPLETED

Location _____

Rig up _____

Drilling and Remarks:

Oka 83640
2000 acid

P 82154

RECORD

Cased _____ in., _____ ft.

Sand _____

Gas _____

Oil _____

Total Depth 3651

PRODUCTION

1st 24 hrs. Nat. _____

1st 24 hrs. after shot _____

Gas _____ Cu. Ft.

Dry Hole _____

Abandoned _____

Date

OCT 21 1936 19 S. J. LEWIS Scout