


Section 32 Township 31 Range KANSAS 1-W

Well Number 5 Murphy

Company Transwestern Oil

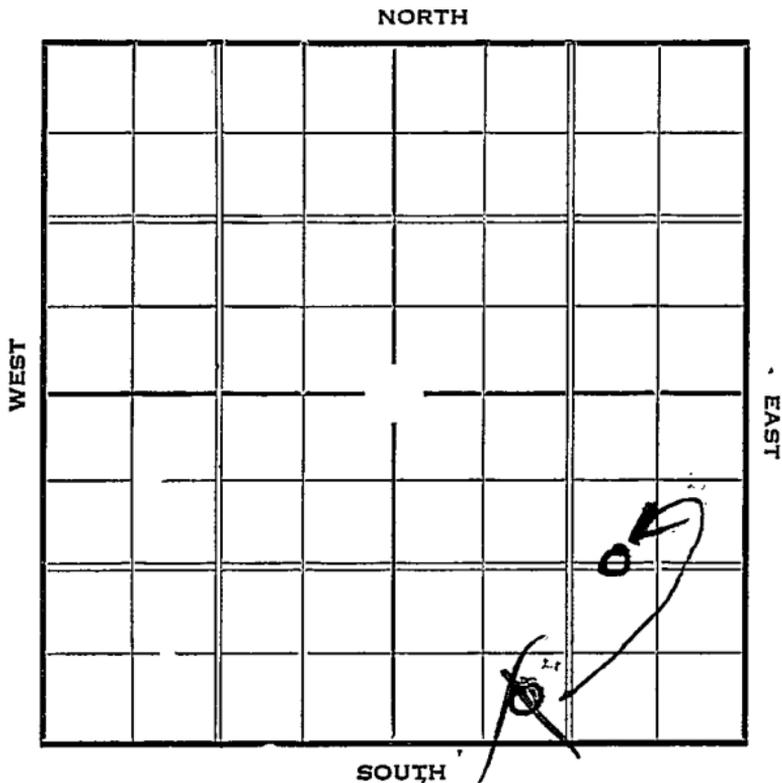

1937

4/14

Chat 3671'.

T.D. 3715'.

5000 acid.

Potential 568.

COMPLETED

KANSAS

Map No. 31 Sec. 32 Twp. 31 R. 14

Well No. 5 Murphy

Transwestern Oil Company

Contractor _____

SECTION PLAT

_____ Ft. from N. Line

330 Ft. from S. Line

_____ Ft. from E. Line

990 Ft. from W. Line

FIRST REPORT

Location ✓

Rig up _____

Drilling and Remarks:

RECORD

Cased _____ in., _____ ft.

Sand _____

Gas _____

Oil _____

Total Depth _____

PRODUCTION

1st 24 hrs. Nat. _____

1st 24 hrs. after shot _____

Gas _____ Cu. Ft.

Dry Hole _____

Abandoned _____

Date

DEC 16 1935 19

S. J. LEWIS Scout

Map No. 31 Sec. 32 Twp. 31 R. 11W

Well No. 5 Murphy

Transwestern Oil Company

Contractor

SECTION PLAT

			8

_____ Ft. from N. Line

1320 Ft. from S. Line

990 Ft. from E. Line

_____ Ft. from W. Line

CORRECTION

Location _____

Rig up _____

Drilling and Remarks:

*Reported
S.E. SW. SE.*

RECORD

Cased _____ in., _____ ft.

Sand _____

Gas _____

Oil _____

Total Depth _____

PRODUCTION

1st 24 hrs. Nat. _____

1st 24 hrs. after shot _____

Gas _____ Cu. Ft.

Dry Hole _____

Abandoned _____

Date

JAN 27 1937 19

S. J. LEWIS

Scout

KANSAS *Sumner*

Map No. _____ Sec. *32* Twp. *31* R. *1W*

Well No. *5 Murphy*

Transwestern Oil Company

Contractor _____

SECTION PLAT

			<i>0</i>

_____ Ft. from N. Line

1820 Ft. from S. Line

990 Ft. from E. Line

_____ Ft. from W. Line

COMPLETED

Location _____

Rig up _____

Drilling and Remarks:

Chat 3671

5000 acid

Potential

568'

RECORD

Cased _____ in., _____ ft.

Sand _____

Gas _____

Oil _____

Total Depth *3715*

PRODUCTION

1st 24 hrs. Nat. _____

1st 24 hrs. after shot _____

Gas _____ Cu. Ft.

Dry Hole _____

Abandoned _____

Date

APR 14 1937 ₁₉

S. J. LEWIS Scout