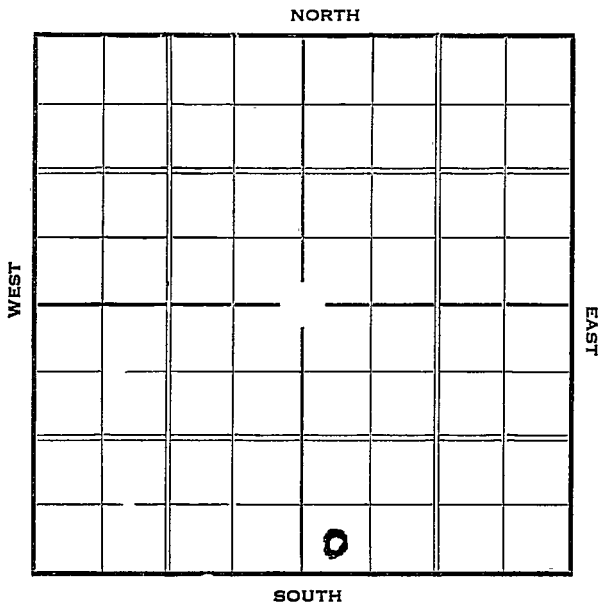


Sumner


KANSAS

Section 32 Township 31 Range 1-WWell Number 6 MurphyCompany Transwestern Oil

Map No. _____ Sec. 32 Twp. 31 R. 1-WWell No. #6 Murphy Farm __________ Trans-Western Oil Company _____330 Ft. from N. Line

_____ Ft. from S. Line

_____ Ft. from E. Line

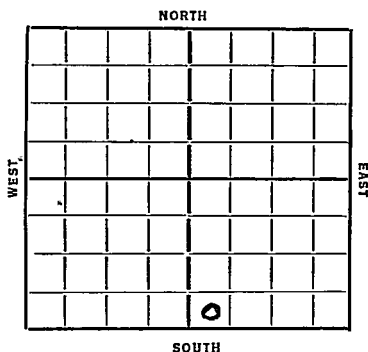330 Ft. from W. LineElev. 1282Date
1936

REPORT

12/16 Location12/24 " 12/29--19371/7 Location1/14 "1/21 "1/28 "2/4 R O C2/11 "2/18 Drlg. 751'.2/26 Drlg. 3397'3/4 Chat 3652'. 7" @ 3657' WOC.3/11 TD 3692'. 2000 acid flow 217 bbls
13 hrs.3/18 " " " " " " "3/25 " " " " " "4/2 1000 acid. No test.

OVER

1937

4/7

Chat 3652'.

T. D. 3692'.

3000 acid.

Potential 460.

COMPLETED

Map No. 31 Sec. 32 Twp. 31 R. 1W

Well No. 6 Murphy

Transwestern Oil Company

Contractor

SECTION PLAT

 Ft. from N. Line

330 Ft. from S. Line

 Ft. from E. Line

330 Ft. from W. Line

FIRST REPORT

Location ✓

Rig up

Drilling and Remarks:

RECORD

Cased in., ft.

Sand

Gas

Oil

Total Depth

PRODUCTION

1st 24 hrs. Nat.

1st 24 hrs. after shot

Gas Cu. Ft.

Dry Hole

Abandoned

Date

DEC 16 1936

19

S. J. LEWIS

Scout

KANSAS*Summer*Map No. 31 Sec. 22 Twp. 21 R. 1WWell No. 6 MurphyTranswestern Oil Company

Contractor

SECTION PLAT

		0	

 Ft. from N. Line330 Ft. from S. Line Ft. from E. Line330 Ft. from W. Line**COMPLETED**Location Rig up

Drilling and Remarks:

*Chas 3652.**3000 acid**Potential**460***RECORD**Cased in., ft.Sand Gas Oil Total Depth 3692**PRODUCTION**1st 24 hrs. Nat. 1st 24 hrs. after shot Gas Cu. Ft.Dry Hole Abandoned

Date

APR '7 1937**S J LEWIS**

Scout