


Section 32 Township 31 Range 1-W

Well Number 7 Murphy

Company Transwestern Oil

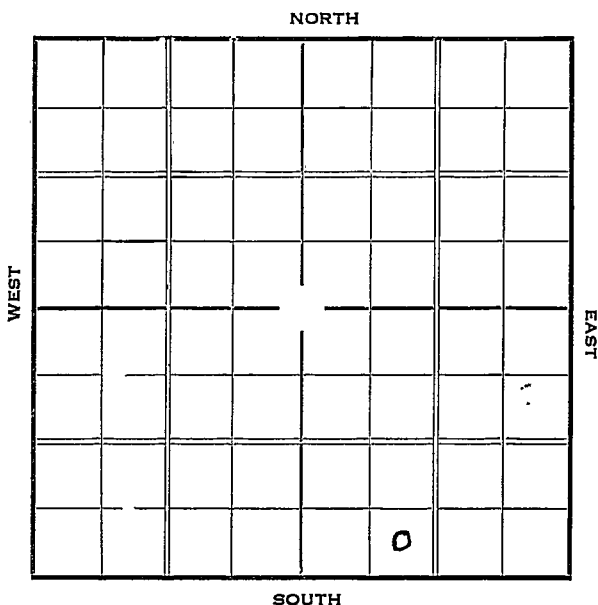

# KANSAS Sumner

Sec. 32 Twp. 31 R. 1-W

Well No. #7 Murphy Farm

Trans Western Oil Company


\_\_\_\_\_ Ft. from N. Line

330 Ft. from S. Line

\_\_\_\_\_ Ft. from E. Line

990 Ft. from W. Line

*Elev. 1241*

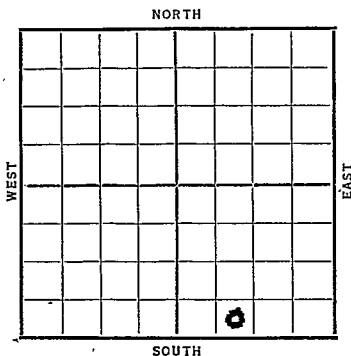

Date	REPORT
1937	
2/10	Location
2/18	Rigging up
2/26	10" @ 351' Drlg. 410'
3/4	Drlg. 2530'.
3/11	Drlg. 3571'.
3/18	Chat. 3656' 7" @ 3659' RUST
3/25	T.D. 3699'. 3000 acid.
	Testing.
4/2	T.D. 3708'. Pump 335bbbls 24 hrs.
4/7	Chat 3656'.
	T. D. 3708'.
	3000 acid.
	Potential 335.
	<b>COMPLETED</b>

# KANSAS

Map No. \_\_\_\_\_ Sec. 32 Twp. 31 R. 1W

Well No. 7 Murphy

Transwestern Oil Company

Contractor \_\_\_\_\_

### SECTION PLAT

			0

\_\_\_\_\_ Ft. from N. Line

380 Ft. from S. Line

\_\_\_\_\_ Ft. from E. Line

990 Ft. from W. Line

### FIRST REPORT

Location ✓

Rig up \_\_\_\_\_

Drilling and Remarks:

### RECORD

Cased \_\_\_\_\_ in., \_\_\_\_\_ ft.

Sand \_\_\_\_\_

Gas \_\_\_\_\_

Oil \_\_\_\_\_

Total Depth \_\_\_\_\_

### PRODUCTION

1st 24 hrs. Nat. \_\_\_\_\_

1st 24 hrs. after shot \_\_\_\_\_

Gas \_\_\_\_\_ Cu. Ft.

Dry Hole \_\_\_\_\_

Abandoned \_\_\_\_\_

Date

FEB 10 1937 19

S. J. LEWIS Scout

**KANSAS** *Sumner Co*

Map No. \_\_\_\_\_ Sec. 22 Twp. 31 R. 1W.

Well No. 7 Murphy

Transwestern Oil Company

Contractor

**SECTION PLAT**


\_\_\_\_\_ Ft. from N. Line

320 Ft. from S. Line

\_\_\_\_\_ Ft. from E. Line

990 Ft. from W. Line

**COMPLETE**

Location \_\_\_\_\_

Rig up \_\_\_\_\_

Drilling and Remarks:

*Chat 3656.*

*3000 acid*

*Potential*

*325*

**RECORD**

Cased \_\_\_\_\_ in., \_\_\_\_\_ ft.

Sand \_\_\_\_\_

Gas \_\_\_\_\_

Oil \_\_\_\_\_

Total Depth 3708

**PRODUCTION**

1st 24 hrs. Nat. \_\_\_\_\_

1st 24 hrs. after shot \_\_\_\_\_

Gas \_\_\_\_\_ Cu. Ft.

Dry Hole \_\_\_\_\_

Abandoned \_\_\_\_\_

Date

APR 7 1937<sub>19</sub>

**S. J. LEWIS**

Scout