

Harper

KANSAS  
5W

32

31S

SECTION \_\_\_\_\_ TOWNSHIP \_\_\_\_\_ RANGE \_\_\_\_\_

WELL NO. #1 Wadman


COMPANY Kaiser & Francis

NORTH

C N/2 SE NE

WEST

EAST

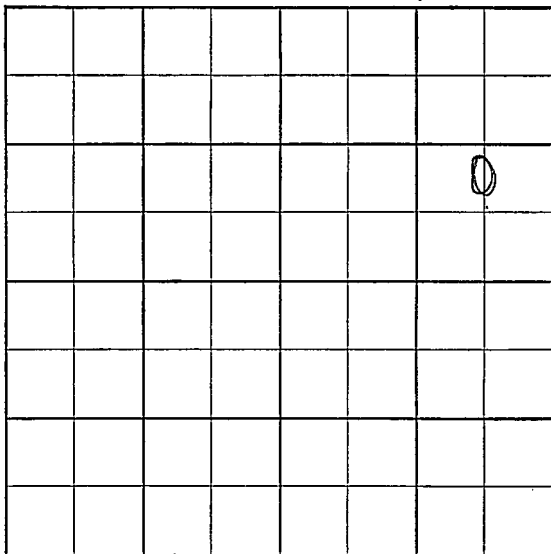

SOUTH



