

STATE CORPORATION COMMISSION OF KANSAS
OIL & GAS CONSERVATION DIVISION
WELL COMPLETION OR RECOMPLETION FORM
ACO-1 WELL HISTORY
DESCRIPTION OF WELL AND LEASE

```
Operator: License # 4328
Name Global Natural Resources Corp.
Address P. O. Box 4682
City/State/Zip Houston, Texas 77210
```

Purchaser.....n/a.....
.....

Operator Contact Person Gail Werner
Phone (713) 880-5464

Contractor: License # 5147
Name PEREIXO, INC.

Wellsite Geologist.....
Phone.....

Designate Type of Completion

X New Well Re-Entry Workover

___ J11	___ SwD	___ Temp Abd
<u>X</u> Gas	___ Inj	___ Delayed Comp.
___ Dry .	___ Other (Core, Water Supply etc.)	

If CHNO: old well Info as follows:

```
Operator .....
Well Name .....
Comp. Date .....Old Total Depth.....
```

WELL HISTORY

Drilling Method:

Mud Rotary Air Rotary Cable

9-17-86	9-29-86	SI WOPL
.....		
Spud Date	Date Reached TD	Completion Date

```

5750          CIBP @ 5461'
.....
Total Depth  PSTD

```

Amount of Surface Pipe Set and Cemented at.....feet
Multiple Stage Cementing Collar Used? X Yes ___ No
If yes, show depth set.....^{3464'}.....feet
If alternate 2 completion, cement circulated
from.....feet depth to.....w/.....SX cmt
Cement Company Name
Invoice #

APR MO. 15-175-20,915

County.....Seward.....

NE NE NE Sec 16 Twp 31S Rge 33 East
..... W West

.....4950' Ft North from Southeast Corner of Section
.....330 Ft West from Southeast Corner of Section
(Note: Locate well in section plat below)


Lease Name.....Toland.....Well #.....1-16.....

Field Name.....Wildcat.....

Producing Formation.....Morrow.....

Elevation: Ground.....2897.....KB.2909.....

Section Plat

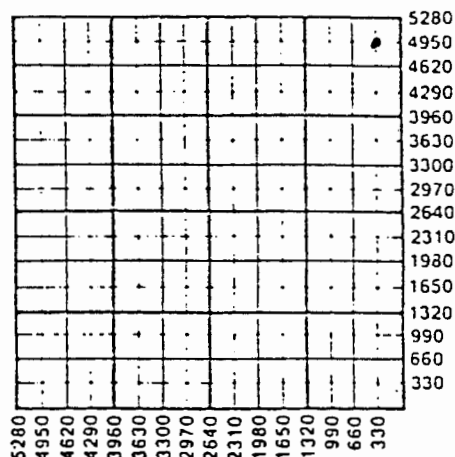

WATER SUPPLY INFORMATION

Disposition of Produced Water:	Disposal
Docket #	Repressuring

Questions on this portion of the ACO-1 call:

Water Resources Board (913) 296-3717

Source of Water:

Division of Water Resources Permit

Groundwater.....Ft North from Southeast Corner
(Well)Ft West from Southeast Corner of
Sec Twp Rge East West

Surface Water.....Ft North from Southeast Corner
(Stream,pond etc).....Ft West from Southeast Corner

Sec	Twp	Rge	East	West
-----	-----	-----	------	------

Other (explain).....
(purchased from city, R.W.D. #)

INSTRUCTIONS: This form shall be completed in triplicate and filed with the Kansas Corporation Commission, 200 Colorado Derby Building, Wichita, Kansas 67202, within 120 days of the spud date of any well. Rule 82-3-130, 82-3-107 and 82-3-106 apply.

Information on side two of this form will be held confidential for a period of 12 months. If requested in writing and submitted with the form. See rule 82-3-107 for confidentiality in excess of 12 months.

One copy of all wireline logs and drillers time log shall be attached with this form. Submit CP-4 form with all plugged wells. Submit CP-111 form with all temporarily abandoned wells.