

*and*

STATE CORPORATION COMMISSION OF KANSAS  
OIL & GAS CONSERVATION DIVISION

WELL COMPLETION OR RECOMPLETION FORM  
ACO-1 WELL HISTORY

DESCRIPTION OF WELL AND LEASE

Operator: License # 5476  
Name DNB Drilling, Inc  
Address 535 N. Oliver  
City/State/Zip Wichita, KS 67208

Purchaser NA

Operator Contact Person James Donelson  
Phone (316) 687-5471

Contractor: License # 5382  
Name Cheyenne Drilling, Inc

Wellsite Geologist David Brewer  
Phone (316) 687-6406

Designate Type of Completion  
 New Well     Re-Entry     Workover

Oil                     SWD                     Temp Abd  
 Gas                     Inj                     Delayed Comp.  
 Dry                     Other (Core, Water Supply etc.)

If OWWO: old well info as follows:  
Operator .....  
Well Name .....  
Comp. Date ..... Old Total Depth.....

WELL HISTORY

Drilling Method:  
 Mud Rotary     Air Rotary     Cable  
11-23-84      12-6-84      12-7-84  
Spud Date      Date Reached TD      Completion Date  
5970  
Total Depth      PBTD

Amount of Surface Pipe Set and Cemented at 17.5 feet  
Multiple Stage Cementing Collar Used?  Yes  No  
If yes, show depth set.....feet  
If alternate 2 completion, cement circulated  
from.....feet depth to.....w/.....SX cmt

API NO. 15-175-20.812  
County Seward  
..... NE NW Sec. 29 Twp. 31 Rge. 33  East  West

4620..... Ft North from Southeast Corner of Section  
3300..... Ft West from Southeast Corner of Section  
(Note: Locate well in section plat below)

Lease Name Lewsar, Inc Well # 1

Field Name Wildcat


Producing Formation NA

Elevation: Ground 2884 KB 2893

Section Plat

*KE-KCL*

RECEIVED  
DEC 26 1984

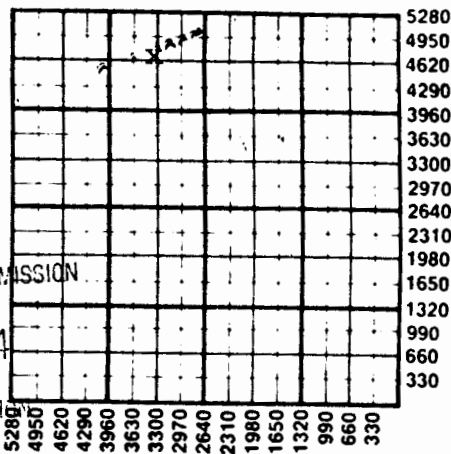

STATE CORPORATION COMMISSION  
Wichita, Kansas

WATER SUPPLY INFORMATION

Disposition of Produced Water:  Disposal  
Docket # .....  Repressuring

Questions on this portion of the ACO-1 call:  
Water Resources Board (913) 296-3717

Source of Water:  
Division of Water Resources Permit # NA

Groundwater.....Ft North from Southeast Corner  
(Well) .....Ft West from Southeast Corner of  
Sec Twp Rge  East  West

Surface Water.....Ft North from Southeast Corner  
(Stream, pond etc).....Ft West from Southeast Corner  
Sec Twp Rge  East  West

Other (explain) Hauled by contractor..  
(purchased from city, R.W.D. #)

INSTRUCTIONS: This form shall be completed in duplicate and filed with the Kansas Corporation Commission, 200 Colorado Derby Building, Wichita, Kansas 67202, within 90 days after completion or recompletion of any well. Rule 82-3-130 and 82-3-107 apply. Information on side two of this form will be held confidential for a period of 12 months if requested in writing and submitted with the form. See rule 82-3-107 for confidentiality in excess of 12 months. One copy of all wireline logs and drillers time log shall be attached with this form. Submit CP-4 form with all plugged wells. Submit CP-111 form with all temporarily abandoned wells.

DRILLER'S LOG X

D N B Drilling, Inc.  
Lewsar Inc. #1  
NE NW 29  
Section 27 - T31S - R33W  
Seward County, Kansas

Commenced: 11-23-84  
Completed: 12-07-84

Surface Casing: 1706' of 8-5/8"  
cmtd w/625 sx Howco Lite, 2% cc,  
1/4# flocele per sx, 300 sx Class  
H, 3% cc, Displace w/105 bbl  
water

FORMATION

DEPTH

Surface Hole	0 - 1707
Shale, Anhydrite	1707 - 2290
Shale, Lime	2290 - 2927
Stone Corral	2927 - 3262
Shale	3262 - 3292
Stone Corral	3292 - 3739
Shale, Lime	3739 - 3975
Lime, Shale	3975 - 4120
Heebner	4120 - 4270
Lansing	4270 - 4860
Marmaton	4860 - 5380
Morrow	5380 - 5592
Mississippian	5592 - 5970 RTD


I do hereby certify that the foregoing statements are true and correct to the best of my knowledge and belief.

CHEYENNE DRILLING, INC.

A. J. Jacques

STATE OF KANSAS: ss:

Subscribed and sworn to before me this 7th day of December, 1984.

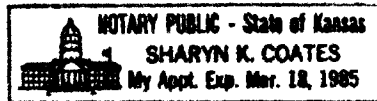

Sharyn K. Coates, Notary Public

DEC 7 1984

State Geological Survey