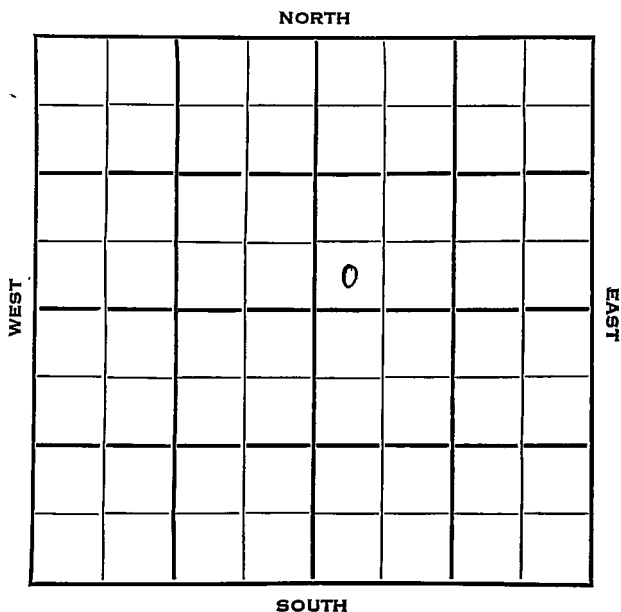


Section 33 Township 31 Range 34 WWell No. # 1 SchnellbacherCompany Northern Natural Gas


SEC.	TWP.	R.
33	31	31 W ✓
WELL NO.		
# 1 Schnellbacher		
COMPANY		FARM
Northern Natural Gas		
CONTRACTOR		

_____ Ft. from N. Line

330 _____ Ft. from S. Line

_____ Ft. from E. Line

330 _____ Ft. from W. Line

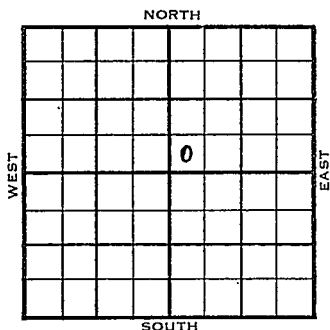

SW SW NE

	ELEVATION	REPORT
1954	2833	
4/14	Spud 4-8-54 10" @ 460 Drlg. 1955'	
6/9	Spudding 4-8-54 Gas Well TD 2642 10" : 460 Hol 2461 Her. 2502 Kri. 2562 TD 2499 7" @ 2488 DD 2622 25000A DD 2642 14000A 2 $\frac{1}{4}$ mcfg Win 2610 Comp 3,253,000 gas	
	COMPLETED	

J. G. McGEHEE

County Seward State Kansas

Sec. 33 (Blk. Twp.) 31 (Sur. Rge.) 34 W Map No.

Operator Northern Natural Gas

Well No. 1 Farm Schnellbacher

Elev. 2833 Location SW SW NE

COMPLETE

330 Ft. From S Line NE

330 Ft. From W Line Quarter

1st. Report

Completion JUN 9 1954

Remarks

Spudding Date 4-8-54

Drilg. Data Gas well TD 2642

10" @ 460 Hol. 2461 Her. 2502

Kri. 2562 TD 2499 7" @ 2488 DD 2622

25000 A DD 2642 14000 A $2\frac{1}{4}$ mcf/g

Win. 2610 Comp. 3,253,000 gas

J. G. McGEHEE