
FORM 51 25M 3-49 PETROL **KANSAS** Stevens

Section 33 Township 31 Range 37W

Well No. 1 McCreey

Company Hugoton Prod.

Stevens County, Hugoton Pool

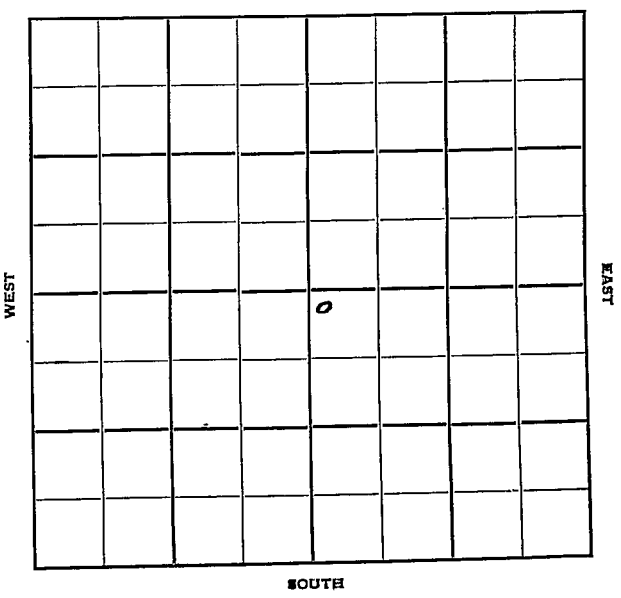

FORM 252-A
5M 10-48 PETROL

KANSAS

Stevens

Sec. 33 Twp. 31 R. 37W ✓

Well No. #1 McCreey Farm

Hugoton Prod. Company

Hugoton Pool


100' Ft. from N. Line

Ft. from S. Line

Ft. from E. Line

100' Ft. from W. Line

NW SE

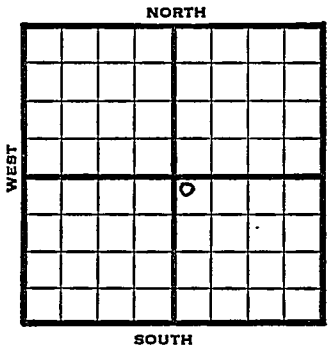

1949	Elev 3124' REPORT
4/20	Location
4/27	"
5/4	"
5/10	"
5/18	10"@ 566' Drlg 1772'
5/25	TD 2530' 7" @ 2523'
6/1	Drlg. 2705'
6/7	TD 2757' 264' of 5" Perf Liner @ 2757'
6/15	"
6/21	"
6/29	TD 2757' 7"@ 2523' 264' of 5" Perf Liner @ 2757' 3,076,000 Gas 422# R Pr. Comp COMPLETED

Form 26 200 Bks. 9-48 Petrol

Kansas

Hugoton Pool

Map No. _____ Sec. 33 Twp. 31 R. 37W

Well No. 1 McCreey

Hugoton Prod. Company

FIRST REPORT

Contractor

NW SE

100 Ft. from N. Line


_____ Ft. from S. Line

_____ Ft. from E. Line

100 Ft. from W. Line

Stevens County

SECTION PLAT

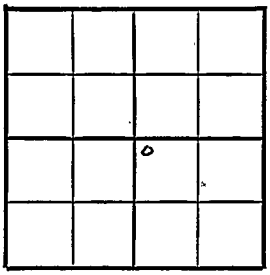

Location x

Rig up

Drilling and Remarks:

RECORD

Cased _____ in., _____ ft.

Sand

Gas

Oil

Total Depth

PRODUCTION

1st 24 hrs. Nat.

1st 24 hrs. after shot

Gas _____ Cu. Ft.

Dry Hole

Abandoned

Date

APR 20 1949 19

S. J. LEWIS Scout

Form 26 200 Bks. 6-49 Petrol Kansas

Hugoton Pool

Map No. 1 Sec. 33 Twp. 31 R. 37W

Well No. 1 McCreey


Hugoton Prod. Company

COMPLETE Contractor

NW SE

E1 3124

SECTION PLAT

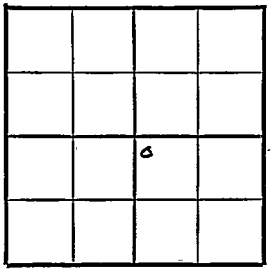

100 Ft. from N. Line

____ Ft. from S. Line

____ Ft. from E. Line

100 Ft. from W. Line

Stevens County

Location

Rig up

Drilling and Remarks:

7" @ 2523

264' of 5" Perf Liner

@ 2757

3076000 Gas

422# RP

RECORD

Cased ____ in., ____ ft.

Sand

Gas

Oil

Total Depth 2757

PRODUCTION

1st 24 hrs. Nat.

1st 24 hrs. after shot

Gas Cu. Ft.

Dry Hole

Abandoned

Date

JUN 29 1949 19

S. J. LEWIS Scout