
FORM 51 25M 3-49 PETROL Stevens KANSAS

Section 33 Township 31 Range 35W

Well No. #6 Jones

Company Northern Natural

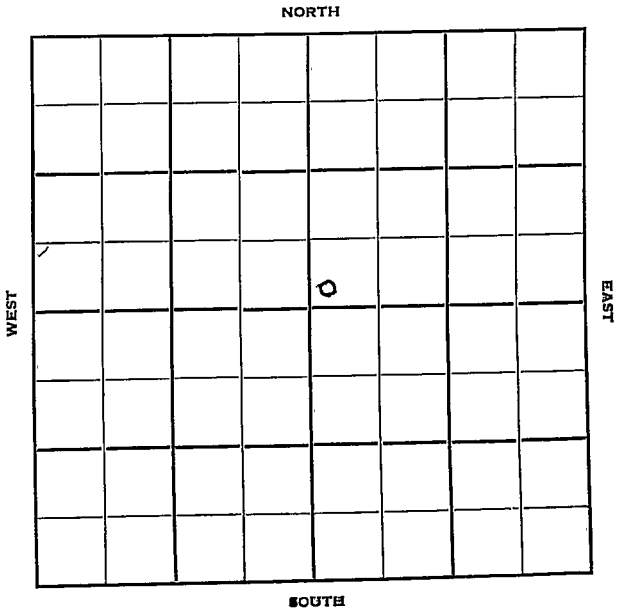

FORM 252-B
10M 9-49 PETROL

KANSAS

Stevens

Sec. 33 Twp. 31 R. 35-W

Well No. #6 Jones Farm

Northern Natural Company

Contractor

Hugoton


Ft. from N. Line

200 Ft. from S. Line

Ft. from E. Line

200 Ft. from W. Line

SW NE

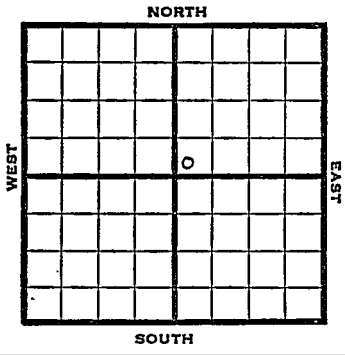

Gas Well

1950

REPORT

Elev 3010

7/26 Location

9/6 10" @ 523
7" @ 2578
TD 2791
Hol 2535 Her 2575
Krider 2635 Odell 2669
Win 2680 Ft. Riley 2719
19000 total acid
Comp 24,687,000 gas
Completed

COMPLETED

Form 26 200 Bks. 11-49 Petrol

Hugoton Pool

Map No. _____ Sec. 33 Twp. 31 R. 35W

Well No. 6 Jones

Northern Natural Company

_____ Contractor

SW NE

SECTION PLAT



_____ Ft. from N. Line

200 Ft. from S. Line

_____ Ft. from E. Line

200 Ft. from W. Line

Stevens County

Location X

Rig up _____

Drilling and Remarks:

RECORD

Cased _____ in., _____ ft.

Sand _____

Gas _____

Oil _____

Total Depth _____

PRODUCTION

1st 24 hrs. Nat. _____

1st 24 hrs. after shot _____

Gas _____ Cu. Ft.

Dry Hole _____

Abandoned _____

Date

JUL 26 1950 19 J F TYRA Scout

FORM 275 FOR SALE BY KANSAS BLUE PRINT CO.


County Stevens State Kansas

Sec. 33 (Blk. Twp.) 31 (Sur. Rge.) 35W Map No.

Operator Northern Natural

Well No. 6 Farm Jones

Elev. 3010 Location SW NE

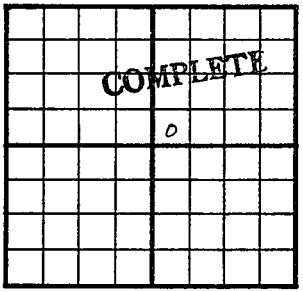

200 Ft. From S Line NE

200 Ft. From W Line Quarter

1st. Report

Completion SEP 6 1950

Remarks

Hugoton Pool

Spudding Date

Drlg. Data Gas well TD 2791

10" @ 523 7" @ 2578 TD 2791

Hol. 2535 Her. 2575 Krider 2635

Odell 2669 Win. 2680 Ft. Riley 2719

19000 total acid Comp. 24,687,000 gas

J. E. TYRA