

Seward

KANSAS

33

31

32W


SECTION _____ TOWNSHIP _____ RANGE _____

#1 Printz

WELL NO. _____

Graham-Michaels

COMPANY _____

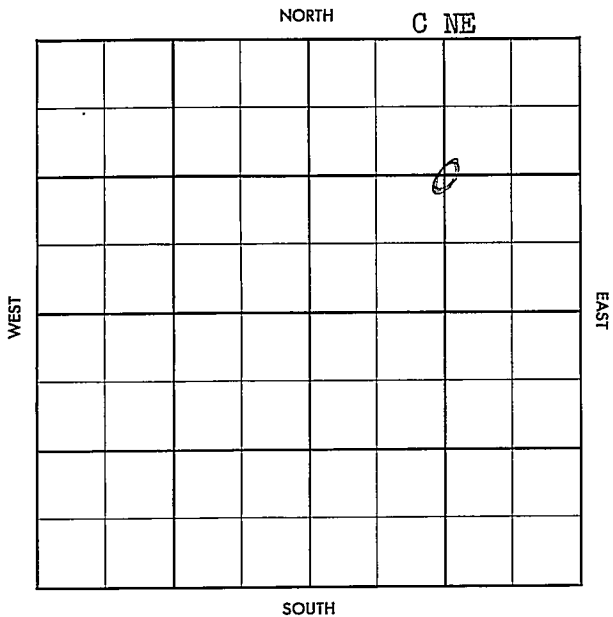

County Seward Elev. _____
 Sec. 31 Twp. 31 Rge. 32W
 Company Graham-Michaelis
 Farm Name Printz No. 1

TOPS	DEPTH	LOG	DATUM	Loc. in Sec.
Anh.				C NE
Tr.				
H.				
Tr.				
Dg.				
Bl.				
L.				Geol. _____
K.C.				Contr. _____
B.K.C.				
Ce.				Co. Tools
C.				Pool
M.				Hugoton
M.				
K.				
Mz.				
Me.				
V.				
S.				
S.				
A.				
R.				
PE.				
G.				
T.D.				

APR 3 '37
 FIRST REPORT

Date Comm. M I R T

[Handwritten signature]

Co.
 Lse.
 No.
 Sec.
 T.
 R.

County Seward Elev. 2850
 Sec. 83 Twp. 31 Rge. 32W
 Company Graham-Michaelis
 Farm Name Printz No. 1

	TOPS	DEPTH	LOG	DATUM
Anb.	<u>Herr</u>		<u>2628</u>	
Tr.	<u>O. Kri</u>		<u>2654</u>	
H.	<u>L. Kri</u>		<u>2681</u>	
Tr.	<u>W. Ed</u>		<u>2730</u>	
Dg.				
Bl.				
L.				
K.C.				
B.K.C.				
Ce.				
C.				
M.				
M.				
K.				
Mz.				
Mo.				
V.				
S.				
S.				
A.				
R.				
PE.				
G.				
T.D.		<u>2742</u>		

Loc. in Sec. _____

C NE

Geol. _____

Contr. _____

Co. Tools

Pool _____

Hugoton

MAY 29 '57

COMPLETE

Date Comm. C.S.O. F.O.

MIRT APR 10 '57 Spd 3-30-57

8 7/8 558/300 MIRT #560

APR 17 '57 5 1/2 2741/300 APR 24 '57 MAY 1 '57

MIRT CO MAY 22 '57 Block 509.

MAY 15 '57 40/2684-94 F120 4x6

92 1.600 MIFL PB 2675 24/

2632-38 48/2658-70 F120

2x3 1/2 92 1.300 MIFL MAY 22 '57 CO

2700 MAY 29 '57 72-20, 92 5 Mill CEG

RP 390 #

Co.

Sec.

No.

Sec.

T.

R.