


Section 33 Township 31 Range 15W

Well No. 1 Skinner

Company Continental Oil Etal

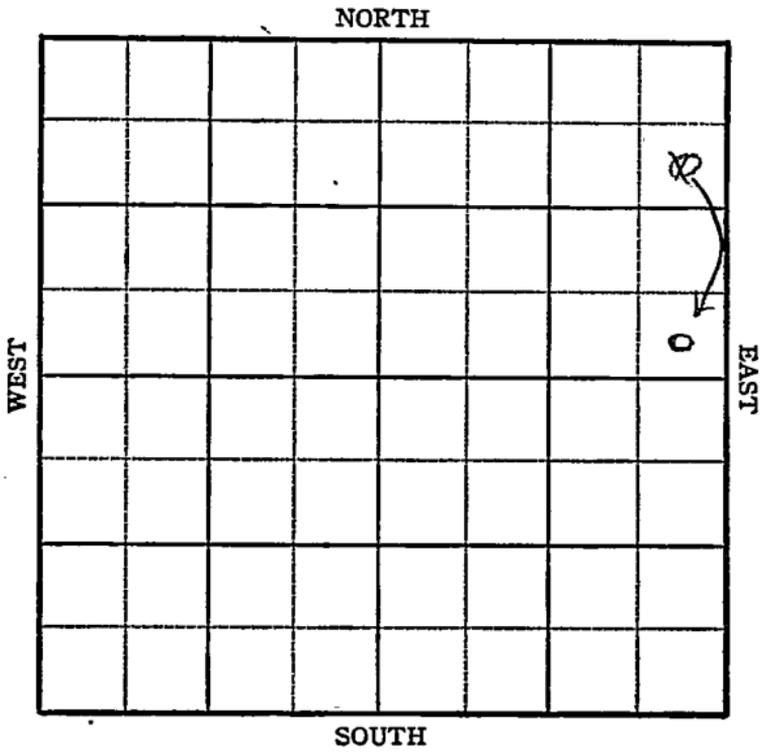

Sec. 33 Twp. 31 R. 15-W

Well No. #1 Skinner Farm


Continental Oil et al Company

990 Ft. from N. Line

330 Ft. from S. Line

330 Ft. from E. Line

_____ Ft. from W. Line

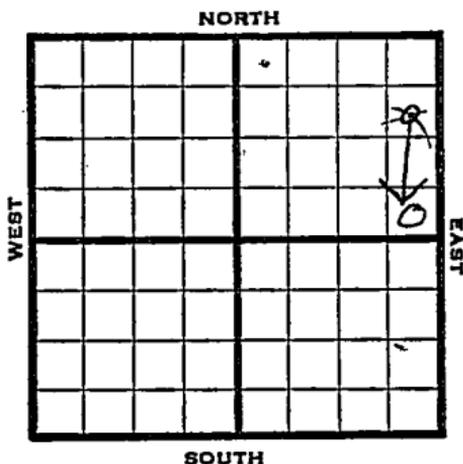

SE NE ~~NE~~

1945 Elv. 1922' REPORT

- 11/14 Derrick
- 11/21 Drlg. 100'
- 11/28 16" @ 200
1150' Run 10"
- 12/5 10" @ 1146
Drlg. 1425
- 12/12 Drlg. 3455
- 12/20 Drlg. 4380'
- 12/29 Lans 4152' Miss 4697' Viola 4902'
Simp 5048' Drlg. 5088'
- 1946
- 1/10 Arb. 5143-67' T.D.
7" - 4845' RUST.
- 1/17 1 shot 4720' 1 shot 4718'
226,000 gas. Plug 4650' C.O.
- 1/24 Plug 4650' 83 shots 4432-4500'
24 shots 4296-4326' Squeeze.
- 1/31 12 shots 4049-60. 12 shots 4061-72.
12 shots 4055-65' Will squeeze.
- 2/7 " " " "
- 2/14 P.B. to 4780' 57 shots 4697-4720'
- 2/21 " " "
- 2/28 2,200,000 cu ft gas.
- 3/7 4000 acid.
- 3/14 1-3/10 M cu ft gas.
- 3/21 " " "
- 3/28 " " "

OVER

1946

4/3 Lans 4152
Arb. 5143
7" @ 4845
Perf. Lans 4000 acid.
TD 5167
2,500,000 Gas.

COMPLETED


KANSAS Pool Name WildcatMap No. 93 Sec. 33 Twp. 31 R. 15WWell No. 1 SkinnerContinental Oil Etal Company

FIRST REPORT

Contractor

SE NE NE

SECTION PLAT

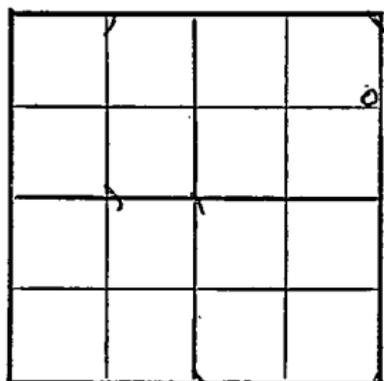990 Ft. from N. Line Ft. from S. Line330 Ft. from E. Line Ft. from W. Line

Barber County

Location Rig up Drilling and Remarks:
derrick

RECORD


Cased in., ft.Sand Gas Oil Total Depth

PRODUCTION

1st 24 hrs. Nat. 1st 24 hrs. after shot Gas Cu. Ft.Dry Hole Abandoned

Date

NOV 14 1945 19S. J. LEWIS Scout

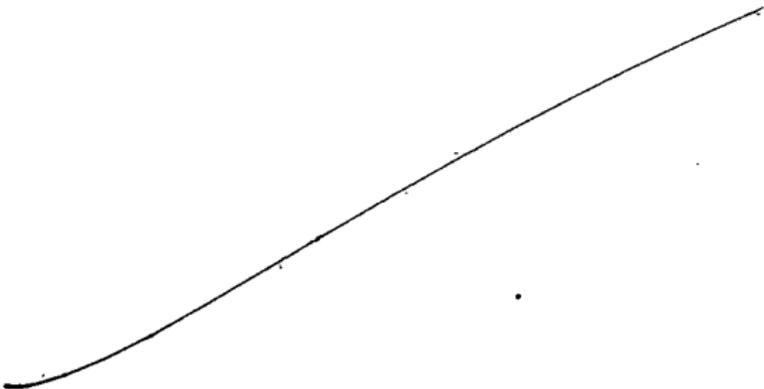

Misc. Small Maps	<i>OK</i>
Cards	<i>Book</i>
Tracing	<i>OK</i>
France Map	<i>OK</i>
Scarborough Map	<i>OK</i>
Pierce Map	<i>OK</i>
Geological Dept.	
Pierce Plat Book	

KANSAS

Kansas Pool Name Wildcat

Map No. 1-93 Sec. 33 Twp. 31 R. 15W

Well No. 1 Skinner

Continental Oil etal Company

CORRECTION

Contractor

SE NE

SECTION PLAT

			o

 Ft. from N. Line

330 Ft. from S. Line

330 Ft. from E. Line

 Ft. from W. Line

Barber Countv

Location

Rig up

Drilling and Remarks:

reported
SE NE NE

RECORD

Cased in., ft.

Sand

Gas

Oil

Total Depth

PRODUCTION

1st 24 hrs. Nat.

1st 24 hrs. after shot

Gas Cu. Ft.

Dry Hole

Abandoned


Date

DEC 1 9 1945

19

S. J. LEWIS

Scout

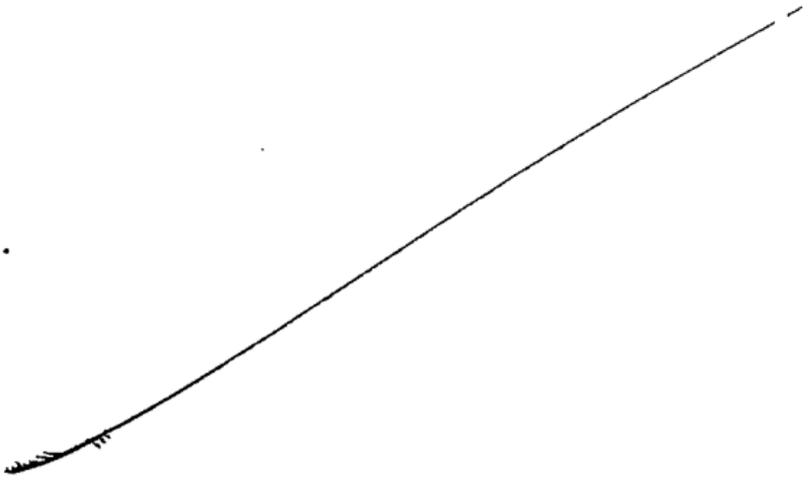

1. 100 S. 100 Maps	<i>OK</i>
Cards	<i>27</i>
Tracing	<i>27</i>
France Map	<i>[Signature]</i>
Scarborough Map	<i>[Signature]</i>
Pierce Map	<i>[Signature]</i>
Geological Dept.	
Pierce Plat Book	

Misc. Small Maps 100
Cards Correctly
Tracing 7
France Map 7
Scarborough Map 1
Pierce Map 1
Geological Dept. _____
Pierce Flat Book _____