


Section 33 Township 31 Range 15WWell No. 1-A SkinnerCompany Aylward Drlg

NORTH

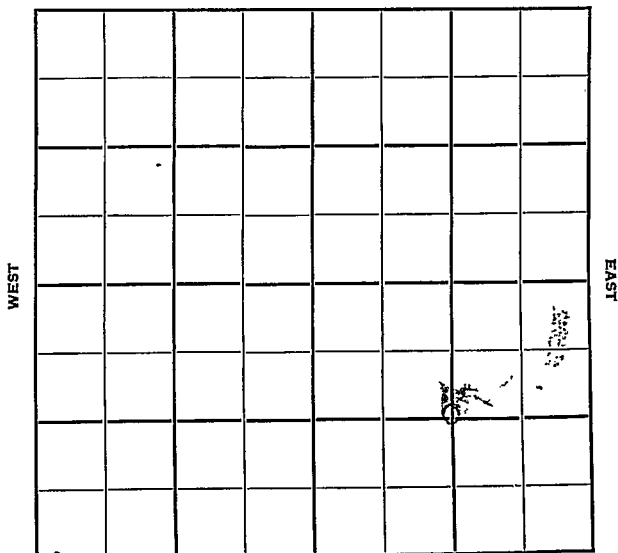

SOUTH

Barber

KANSAS ✓

Sec. 33 Twp. 31 R. 15W

Well No. #1 Skinner Farm


Aylward Drlg. Company

Aylward Drlg. Contractor

Wildcat

Ft. from N. Line

NORTH

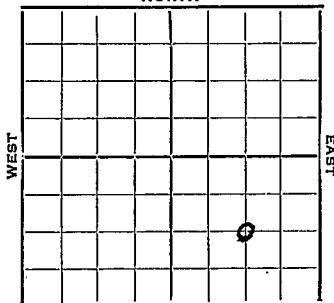

SOUTH

1320 Ft. from S. Line

1320 Ft. from E. Line

Ft. from W. Line

C SE/4

1952 Elev. 1918' REPORT

12/10 RUR

12/11 RUR

12/18 8" @ 295 Anhy 890 Ø2251

12/25 " " " "

1/1 NR

1/8 Heeb 3398 Doug 4070 KC 4177 Cong 47255
Miss 4741 DST 4723-63 RTD 10' Mins 8
Mil gas. 1600# 5" @ 4741

1/22 CO

1/29 CO 4763'

2/4 Spud 12-11-52

Gas Well

TD 4763


8" @ 295

Anhy 890, Heeb 3998, Doug 4070,
KC 4177, Cong 4725, Miss 4741,
DST 4723-63, opn 10 mins., rec. 8
mcfg, 1600#
5" @ 4741, TD 4763
Comp. 4 mcfgpd

COMPLETED

County Barber State Kansas
 Sec. 33 (Blk. 31 (Sur. 15W Map No.
 (Twp.) (Rge.)

Operator Aylward Drlg.
 Well No. 1 Farm Skinner
 Elev. Location C SE/4

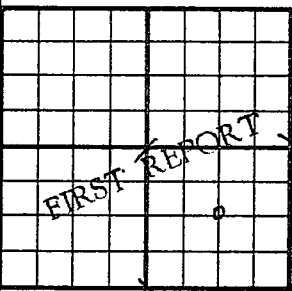

1320 Ft. From S Line SE
1320 Ft. From E Line Quarter

1st. Report DEC 10 1952

Completion

Remarks

Aylward Drlg. - Contr.


Spudding Date

Drlg. Data Wildcat

R U R

J. G. McGEHEE

County Barber State Kansas
 Sec. 33 (Blk. 31 (Sur. 15W Map No. (Twp.) (Rge.)
 Operator Aylward Drlg.
 Well No. 1-A Farm Skinner
 Elev. 1918 Location C SE/4

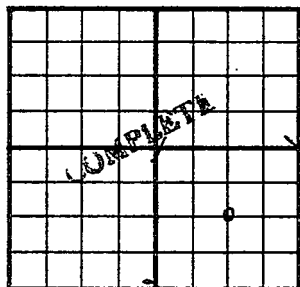

1320 Ft. From S Line SE
1320 Ft. From E Line Quarter
 Ist. Report
 Completion FEB 4 1953
 Remarks Wildcat
Aylward Drlg. - Contr.
 Spudding Date 12-11-52

Drlg. Data Gas well TD 4763
8" @ 295 Anhy 890 Heeb. 3998
Doug. 4070 KC 4177 Cong. 4725
Miss. 4741 DST 4723-63 open 10 min.
Rec. 8 mcfg 1600# 5" @ 4741 TD 4763
Comp. 4 mcfgpd

J. G. McGEHEE