


Section 33 Township 31 Range 15 W

Well No. #2 Skinner "A"

Company Aylward Drlg.

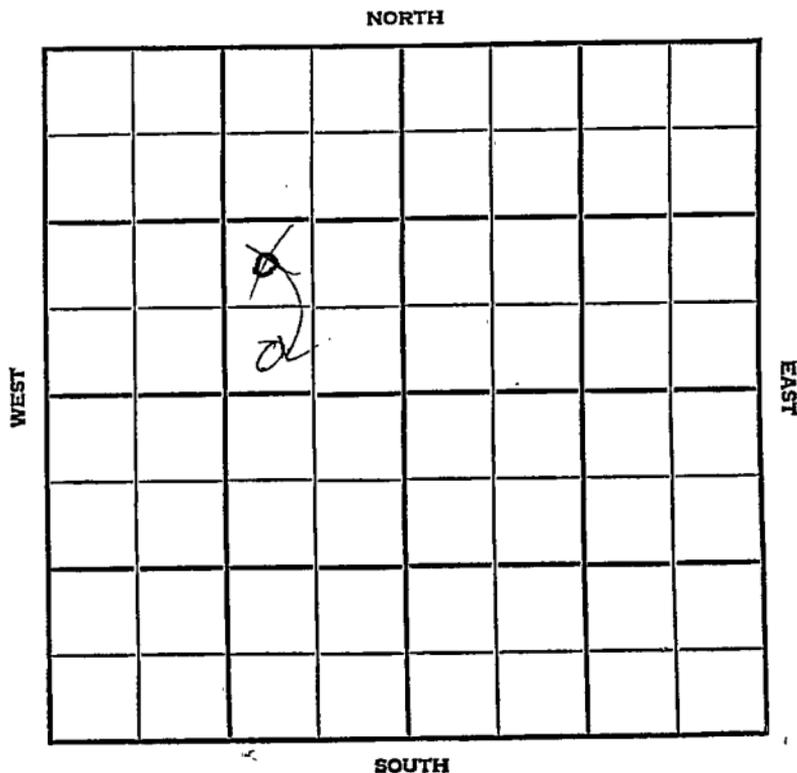

SEC. 33	TWP. 31	R. 15W
---------	---------	--------


WELL NO. #2 Skinner "A" FARM

COMPANY Aylward Drlg.

CONTRACTOR Co. Tools

Donald Gas

_____ Ft. from N. Line
 _____ Ft. from S. Line
 _____ Ft. from E. Line
 _____ Ft. from W. Line

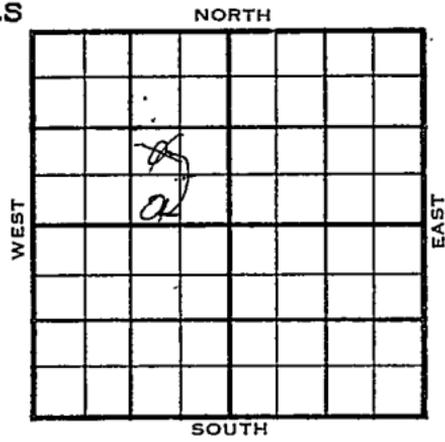

~~NW SE NW~~
 SW SE NW

1956	ELEVATION 1894	REPORT
------	----------------	--------

2-22 MIB
 5-2 Comm. 2-23-56
 8 5/8" @ 565
 5 1/2" @ 4703
 DD 4718
 PB 4711, frac
 Comp. 42 bopd
 H. 3990
 Dg. 4067
 BL. 4140
 L. 4644 - Lens. 4164 - (2270)
 C. 4698
 M. 4702
 TD 4704'

COMPLETED

County Barber Elev. _____
 Sec. 33 Twp. 31 Rge. 15W
 Company Aylward Drlg.
 Farm Name Skimmer "A" No. 2

TOPS	DEPTH	LOG	DATUM	Loc. in Sec.																														
Anh.				NW SE NW																														
Tr.																																		
Dg.																																		
Bl.																																		
L.				Geol. _____																														
K.C.				Contr. _____																														
B.K.C.				Co. tools																														
Ce.				Pool																														
C.				Donald Gas																														
M.				<table border="1"> <tr><td></td><td></td><td></td></tr> </table>																														
M.																																		
K.																																		
Mz.																																		
Mo.																																		
V.																																		
S.																																		
S.																																		
A.																																		
R.																																		
Pe.																																		
G.																																		
T.D.																																		

FIRST REPORT
 FEB 22 '56

Date Comm.
M I R

[Handwritten signature]


Co.
 Use.
 No.
 Sec.
 T.
 R.

CORRECTION

FORM 513 REV. SUNRAY

County Barber Elev. _____
 Sec. 33 Twp. 31 Rge. 15W
 Company Aylward Drlg.
 Farm Name Skinner "A" No. 2

TOPS	DEPTH	LOG	DATUM	Loc. in Sec.
Anh.				SW SE NW
T.P.				
H.				
Tr.				
Dg.				
Bl.				
L.				
K.C.				Geol. _____
B.K.C.				Contr. _____
Ce.				
C.				
M.				
M.				Pool _____
K.				
Mz.				
Mo.				
V.				
S.				
S.				
A.				
R.				
PE.				
G.				
T.D.				

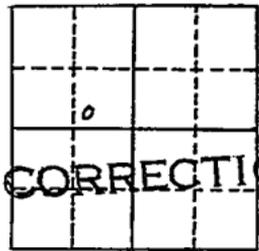

Date-Comm. Reported NW SE NW

MAY 2 1956

Co. Lse. No. Sec. T. R.

County Barber Elev. 1894
 Sec. 33 Twp. 31 Rge. 15W
 Company Aylward Drlg.
 Farm Name Skinner "A" No. 2

TOPS	DEPTH	LOG	DATUM	Loc. in Sec.
Anh.				SW SE NW
Tp.				
H.	<u>3990</u>			
Tr.				
Dg.	<u>4067</u>		<u>2173</u>	
Bl.	<u>4140</u>		<u>2246</u>	
L.	<u>4644</u>		<u>2750</u>	
K.C.				Geol.
B.K.C.				Contr.
Ce.				Co. tools
C.	<u>4698</u>		<u>2804</u>	
M.	<u>4702</u>		<u>2808</u>	
M.				Pool
K.				Donald Gas
Mz.				
Mo.				
V.				
S.				
S.				
A.				
R.				
PE.				
G.				
T.D.	<u>4704</u>			

Date Comm. 2-23-56 MAY 2 1956


8 5/8" @ 565 5 1/2" @ 4703 DD 4718

PB 4711 frac Comp. 42 bopd

County Barber Elev. _____
 Sec. 33 Twp. 31 Rge. 15W
 Company Aylward Drlg.
 FarmName Skinner "A" No. 2

TOPS	DEPTH	LOG	DATUM
Anh.			
Tp.			
H.			
Tr.			
Dg.			
Bl.			
L.			
K.C.			
B.K.C.			
Ce.			
C.			
M.			
M.			
K.			
Mz.			
Mq.			
V.			
S.			
S.			
A.			
R.			
Pe.			
G.			
T.D.			

Loc. in Sec. _____
SW SE NW
 Geol. _____
 Contr. _____
 Pool _____

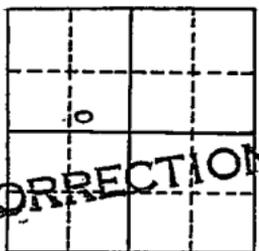

CORRECTION

Date Comm. _____
 Comp. 5-2-56
 Lans. 4644 → Should be 4164 (≈2270)

(Lans will not be listed on County map)

Co.
No.
Lse.
No.
Sec.
T.
R.