

Summer
31 1W

Map No. **KANSAS** Sec. **33** Twp. **31** R. **1W**

Well No. **1- Barlow** Farm
Shover et al Company


_____ Ft. from N. Line

990 Ft. from S. Line

_____ Ft. from E. Line

330 Ft. from W. Line

Elev. 1260

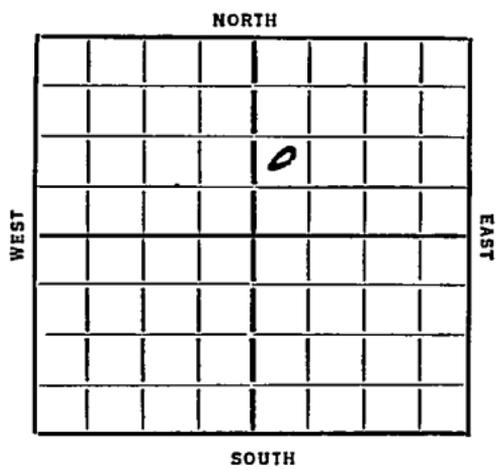

REPORT

Date

~~1933~~
 9/20 *Aug 1933*
 10/3 " *3018*
 10/19 *6" 3646 Rust*
 11/1 *pump 228 A-24 hrs.*
 11/6 *Chert 3642*
T.D. 3696
228 Bble.

COMPLETED

Map No. 31 Sec. 33 Twp. 31 R. 14

Well No. 1-Barlow

Shawnee Company

Contractor

FIRST REPORTS

SECTION PLAT

Ft. from N. Line

990 Ft. from S. Line

Ft. from E. Line

330 Ft. from W. Line

| | | | |
|--|--|---|--|
| | | | |
| | | 0 | |
| | | | |
| | | | |

Location.....

Rig up.....

Drilling and Remarks:

193^f

RECORD

Cased..... in., ft.

Sand.....

Gas.....

Oil.....

Total Depth.....

PRODUCTION

1st 24 hrs. Nat.....

1st 24 hrs. after shot.....

Gas..... Cu. Ft.

Dry Hole.....

Abandoned.....

Date

9-20-35 192.....

ORVAL MANNSCHRECK

Scout

Map No. 31 Sec. 33 Twp. 31 R. 1W

Well No. 1-Barlow

Shawver etal Company

Contractor

COMPLETED SECTION PLAT

.....Ft. from N. Line

990 Ft. from S. Line

.....Ft. from E. Line

330 Ft. from W. Line

| | | | |
|--|--|---|--|
| | | | |
| | | 0 | |
| | | | |
| | | | |
| | | | |

Location.....

Rig up.....

Drilling and Remarks:

228 bbls

RECORD.

Cased.....in.,.....ft.

~~Sand~~ chat 3642

Gas.....

Oil.....

Total Depth 3696

PRODUCTION

1st 24 hrs. Nat.....

1st 24 hrs. after shot.....

Gas.....Cu. Ft.

Dry Hole.....

Abandoned.....

Date

11-6-35 192

ORVAL MANNING RECK

Scout