


Section 33 Township 31 Range 1-W

Well Number 3-Barlow

Company Stelbar et al

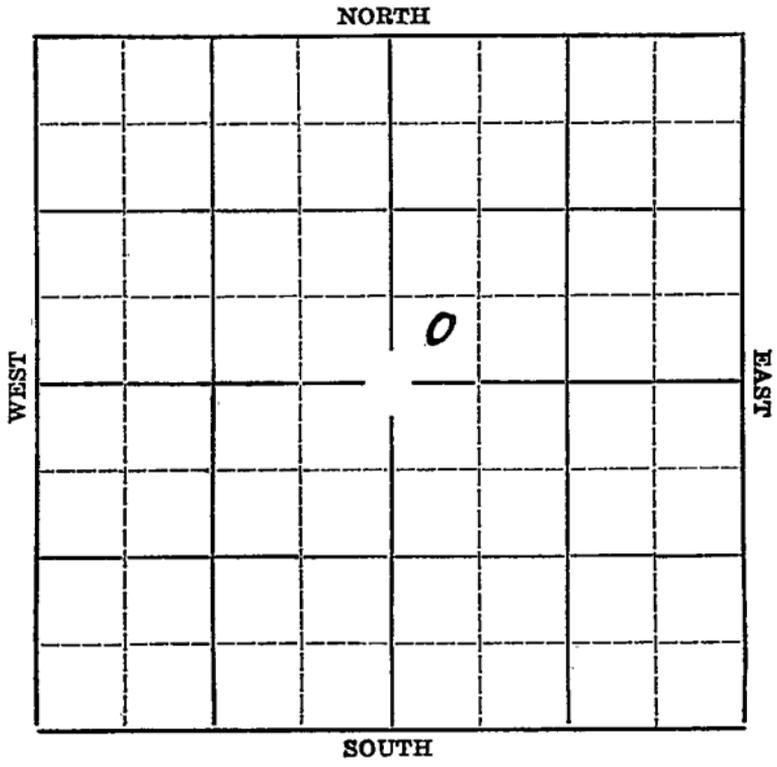

Sumner

Form 252-A
5M 7-35 MPC

Map No. KANSAS Sec. 33 Twp. 31 R. 1W

Well No. #3 Barlow Farm _____

Stelbar et al Company _____


_____ Ft. from N. Line

330' Ft. from S. Line

_____ Ft. from E. Line

330' Ft. from W. Line

Elev. 1249

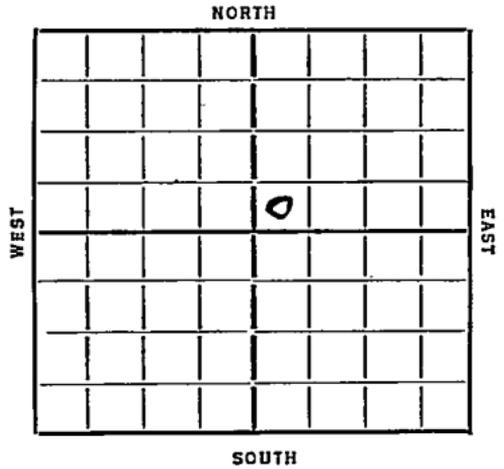

Date
1936

REPORT

4/22 BR. Rotary.

5/7 Drlg. 1865'.

5/14 Drlg. 3104'.

5/21 Rigging up standard tools.

5/28 Chat 3644'. 6" @ 3646'. R.U.S.T.

6/4 T.D. 3682'. 2000 gallons acid.

6/10/36-Chat 3644'.

Total depth 3682'.

2000 gallons acid.

4000 gallons acid.

429 bbls oil.

COMPLETED

Map No. 31 Sec. 33 Twp. 21 R. 1W

Well No. 3 Barlow

Stebbins & Co Company

Contractor

SECTION PLAT

		0	

..... Ft. from N. Line

330 Ft. from S. -Line

..... Ft. from E. Line

330 Ft. from W. Line

FIRST REPORT

Location.....

Rig up.....

Drilling and Remarks:

B.R.
Rotary

RECORD

Cased..... in., ft.

Sand.....

Gas.....

Oil.....

Total Depth.....

PRODUCTION

1st 24 hrs. Nat.....

1st 24 hrs. after shot.....

Gas..... Cu. Ft.

Dry Hole.....

Abandoned.....

Date

APR 22 1936

192.....

S. J. LEWIS

Scout

Map No. 33 Sec. 33 Twp. 21 R. 1W

Well No. 3 Barlow

Stellar & Co. Company

Contractor

SECTION PLAT

		6	

_____ Ft. from N. Line

330 Ft. from S. Line

_____ Ft. from E. Line

330 Ft. from W. Line

COMPLETED

RECORD

Location _____

Cased _____ in., _____ ft.

Rig up _____

Sand _____

Drilling and Remarks:

Gas _____

Chat 3644

Oil _____

2000 acid

Total Depth 3672.

4000 acid

PRODUCTION

429 8/16

1st 24 hrs. Nat. _____

1st 24 hrs. after shot _____

Gas _____ Cu. Ft.

Dry Hole _____

Abandoned _____

Date

JUN 10 1936

19

S. J. LEWIS

Scout