


KANSAS

Form 51-5M-4-36-Palace

Section 33 Township 31 Range 1W

Well Number #1 Barlow

Company Stillbar & Dewar

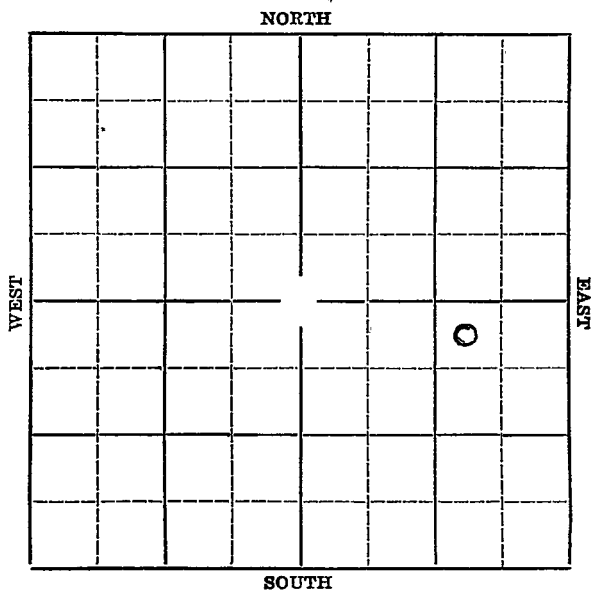

Map No. **KANSAS** Sec. **33** Twp. **31** R. **1-W**


Well No. **1-Barlow** Farm
Stillbar & Dewar Company

330 Ft. from N. Line

Ft. from S. Line

990 Ft. from E. Line

Ft. from W. Line

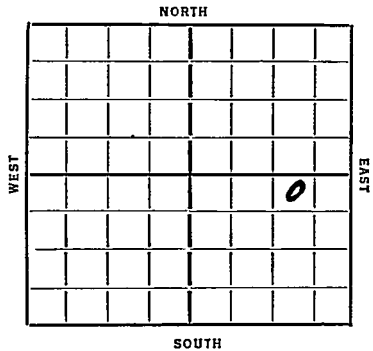

Date
1936

REPORT

4/8 Location

4/16 Rig.

4/23 Drlg. 250'

4/30 Drlg. 1500'.

5/7 Drlg. 2799'.

5/14 Drlg. 3626'.

5/21 Rigging up standard tools.

5/28 Chat 3647'. T.D. 3687'. 1000 acid.

6/4 75 bbls pump.

6/10/36-Chat 3647'.

Total depth 3692'.

1000 gallons acid.

1000 gallons acid.

162½ bbls oil.

COMPLETED

Map No. 31 Sec. 33 Twp. 21 R. 1 W

Well No. 1 Barlow

Gillstar & Hewar Company

Contractor

SECTION PLAT

320 Ft. from N. Line

_____ Ft. from S. Line

990 Ft. from E. Line

_____ Ft. from W. Line

			0

FIRST REPORT

Location ✓

Rig up _____

Drilling and Remarks:

RECORD

Cased _____ in., _____ ft.

Sand _____

Gas _____

Oil _____

Total Depth _____

PRODUCTION

1st 24 hrs. Nat. _____

1st 24 hrs. after shot _____

Gas _____ Cu. Ft.

Dry Hole _____

Abandoned _____

Date

7/8/36 192

S. J. LEWIS

Scout

Samper
 Map No. KANSAS Sec. 133 Twp. 31 R. 14

Well No. 1 Barlow

Stetson & Co. Company

Contractor

SECTION PLAT

380 Ft. from N. Line

_____ Ft. from S. Line

990 Ft. from E. Line

_____ Ft. from W. Line

			o

COMPLETED

Location _____

Rig up _____

Drilling and Remarks:

Chas. 3647

1000 acid

1000 acid

162 1/2 ft.

RECORD

Cased _____ in., _____ ft.

Sand _____

Gas _____

Oil _____

Total Depth 3692

PRODUCTION

1st 24 hrs. Nat. _____

1st 24 hrs. after shot _____

Gas _____ Cu. Ft.

Dry Hole _____

Abandoned _____

Date

JUN 10 1936 19

S. J. LEWIS Scout