


Section 33 Township 31 Range 1W

Well Number 4 Barlow "B"

Company Stelfar

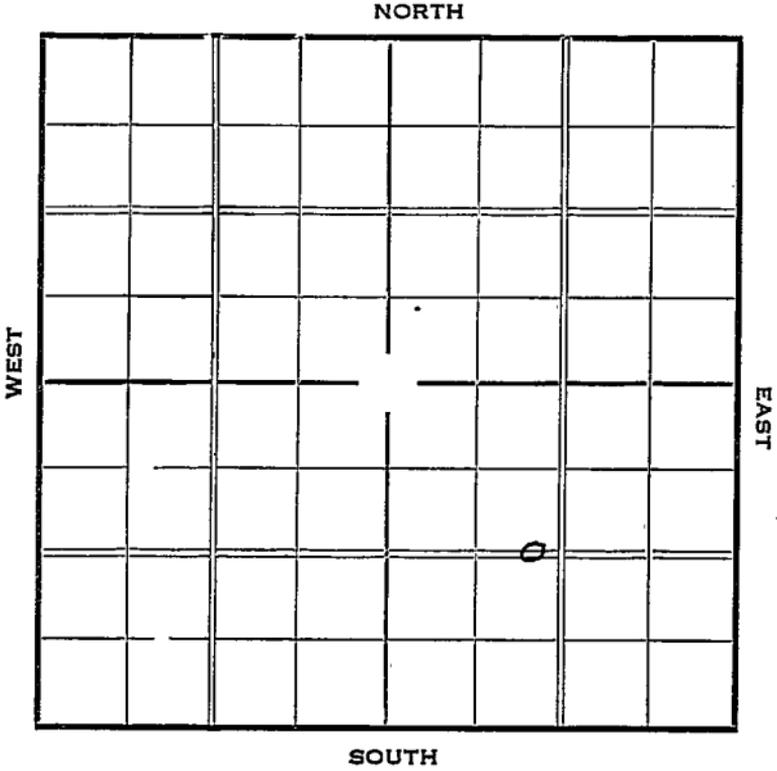

Sec. 33 Twp. 31 R. 1-W

Well No. #4 Barlow "B" Farm

Stelbar Company


_____ Ft. from N. Line

1320 Ft. from S. Line

_____ Ft. from E. Line

990 Ft. from W. Line

Elev. 1261

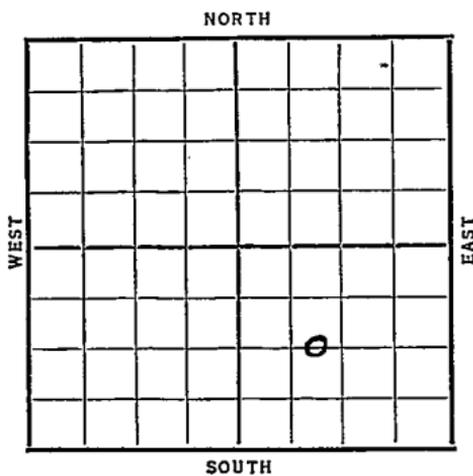

Date 1937

REPORT

1/13 Rigging up.

1/21 Drlg. 275'.

1/28 10" @ 340'. Drlg. 1600'.

2/4 Drlg. 2870'.

2/11 Chat 3653'. 7" @ 3656 RUST

2/18 " "

2/26 " "

3/4 T.D. 3699'. Pump 175 bbls
natural.

3/10 Chat 3653'.

T. D. 3699'.

4000 acid.

Potential 1068.

COMPLETED

KANSAS


Contractor

SECTION PLAT

| | | | |
|--|--|---|--|
| | | | |
| | | | |
| | | | |
| | | 6 | |

_____ Ft. from N. Line

1820 Ft. from S. Line

_____ Ft. from E. Line

990 Ft. from W. Line

FIRST REPORT

Location _____

Rig up _____

Drilling and Remarks:

Rigging up.
S. J. Lewis

RECORD

Cased _____ in., _____ ft.

Sand _____

Gas _____

Oil _____

Total Depth _____

PRODUCTION

1st 24 hrs. Nat. _____

1st 24 hrs. after shot _____

Gas _____ Cu. Ft.

Dry Hole _____

Abandoned _____

Date

JAN 13 1937

19

S. J. LEWIS

Scout

