

Hammer

Map No. KANSAS Sec. 33 Twp. 31 R. 14


Well No. 1- Erker Farm
Shawver et al Company

 Ft. from N. Line

990 Ft. from S. Line

 Ft. from E. Line

330 Ft. from W. Line

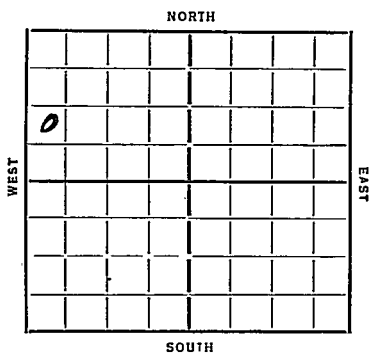

Date 1935

REPORT

3/27 *Rgn Rot.*
4/4 *Qty 240*
4/11 *" 1340*
4/18 *" 2650*
4/26 *" 3410*
5/2 *Chat 3653 6 5/8 3653 Rust*
5/9 *Log Bailer*
5/16
5/23 *3666 flo by hand.*
5/29 *3681 T7 1000 acid*
6/5 *Chat 3653 T7 3694*
1000 acid 409 Bbls

COMPLETED

Map No. 31 Sec. 33 Twp. 31 R. 1WWell No. 1- EckerShawver et al Company

Contractor

FIRST REPORT

Ft. from N. Line

990 Ft. from S. Line

Ft. from E. Line

330 Ft. from W. Line

SECTION PLAT

0			

Location

Rig up

Drilling and Remarks:

Rig w. Rot.

RECORD

Cased.....in.,ft.

Sand.....

Gas.....

Oil.....

Total Depth.....

PRODUCTION

1st 24 hrs. Nat.....

1st 24 hrs. after shot.....

Gas.....Cu. Ft.

Dry Hole.....

Abandoned.....

Date

ORVAL MANNSCHRECK

3-27-35 192.....Scout

1-
N
A long, curved line with a dashed line following its path, ending in a large, stylized 'B' or '13'.

Returned	<i>CPA</i>
Cards	<i>CPA</i>
Tracing	<i>CPA</i>
France Map	<i>X</i>
Scarborough Map	<i>X</i>
Moody Map	<i>X</i>
Scarborough Plat Book	
Moody Plat Book	

KANSAS

Form 26-1M Bks. 9-28

Map No. 31 Sec. 33 Twp. 31 R. 1WWell No. 1- ErkuShawver et al Company

Contractor

COMPLETED

SECTION PLAT

0			

Ft. from N. Line

990 Ft. from S. Line

Ft. from E. Line

330 Ft. from W. Line

Location

Rig up

Drilling and Remarks:

1000 and409 bbls

RECORD

Cased in. ft.Sand Chat 3653

Gas

Oil

Total Depth 3694

PRODUCTION

1st 24 hrs. Nat.

1st 24 hrs. after shot

Gas Cu. Ft.

Dry Hole

Abandoned

Date

6-5-35 192

WANA-CHREK

Scout

[Large handwritten signature across the top half of the page]

Returned	<i>[initials]</i>
Cards	<i>[initials]</i>
Tracing	<i>[initials]</i>
France Map	<i>[initials]</i>
Scarborough Map	<i>[initials]</i>
Moody Map	<i>[initials]</i>
Scarborough Plat Book	
Moody Plat Book	