


Section 33 Township 31 Range 1-W

Well Number #5 X - Barlow "B"

Company Stelbar

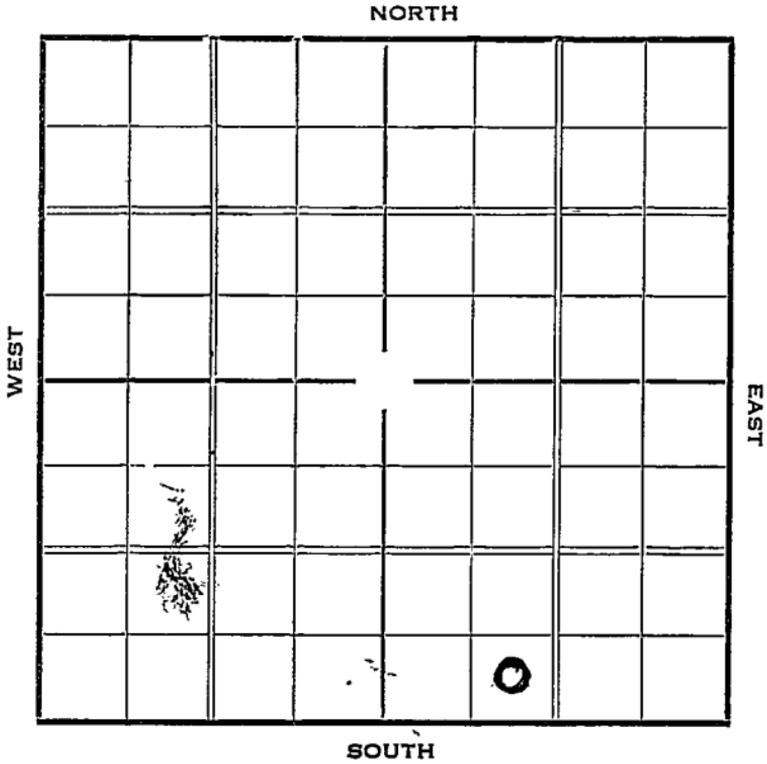

Sec. 33 Twp. 31 R. 1-W

Well No. #5 ~~Barlow~~ "B" Farm


Stelbar Company

\_\_\_\_\_ Ft. from N. Line

330 Ft. from S. Line

\_\_\_\_\_ Ft. from E. Line

990 Ft. from W. Line

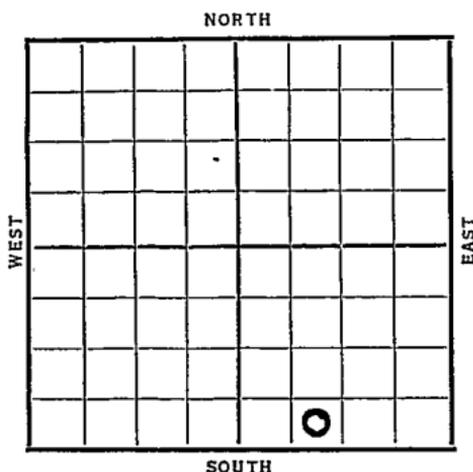

Date	REPORT
1937	
5/26	B.R.
6/4	R U R
6/11	10" @ 338'. Drlg. 945'.
6/19	Drlg. 2792'.
6/25	Drlg. 3600'.
7/2	Chat 3654 & 7". WOC.
7/9	T.D. 3691'. Flowed 140 bbls per hr. Nat.
7/14	7" @ 3654'.
	Chat 3654'.
	T.D. 3691'.
	Pot. 1069 bbls. flowing.
	<b>COMPLETED</b>

Summer **KANSAS**Map No. 31 Sec. 33 Twp. 31 R. 1 WWell No. 7 Barlow "B"Stelbar Company

Contractor

## A FIRST REPORT

## SECTION PLAT

\_\_\_\_\_ Ft. from N. Line

330 Ft. from S. Line

\_\_\_\_\_ Ft. from E. Line

990 Ft. from W. Line

			o

Location \_\_\_\_\_

Rig up \_\_\_\_\_

Drilling and Remarks:

D.R.

## RECORD

Cased \_\_\_\_\_ in., \_\_\_\_\_ ft.

Sand \_\_\_\_\_

Gas \_\_\_\_\_

Oil \_\_\_\_\_

Total Depth \_\_\_\_\_

## PRODUCTION

1st 24 hrs. Nat. \_\_\_\_\_

1st 24 hrs. after shot \_\_\_\_\_

Gas \_\_\_\_\_ Cu. Ft.

Dry Hole \_\_\_\_\_

Abandoned \_\_\_\_\_

Date

MAY 26 1937 19

H. D. Hatfield  
Scout

*Summer* **KANSAS**

Map No. 31 Sec. 33 Twp. 31 R. 1 W

Well No. 5-Barlow "B"

Stelbar Company

Contractor

**CORRECTION**

**SECTION PLAT**

\_\_\_\_\_ Ft. from N. Line

<sup>45</sup> 330 Ft. from S. Line

\_\_\_\_\_ Ft. from E. Line

990 Ft. from W. Line

			0

Location \_\_\_\_\_

Rig up \_\_\_\_\_

Drilling and Remarks:

*1st reported as #7 but has been changed to above no.*

**RECORD**

Cased \_\_\_\_\_ in., \_\_\_\_\_ ft.

Sand \_\_\_\_\_

Gas \_\_\_\_\_

Oil \_\_\_\_\_

Total Depth \_\_\_\_\_

**PRODUCTION**

1st 24 hrs. Nat. \_\_\_\_\_

1st 24 hrs. after shot \_\_\_\_\_

Gas \_\_\_\_\_ Cu. Ft.

Dry Hole \_\_\_\_\_

Abandoned \_\_\_\_\_

Date

# KANSAS

Form 26—1M Bks.—2-29

*Summer*Map No. 31 Sec. 33 Twp. 31 R. 1 WWell No. 5-Barlow "B"Stellar Company

Contractor

**COMPLETED****SECTION PLAT**

			0

\_\_\_\_\_ Ft. from N. Line

330 Ft. from S. Line

\_\_\_\_\_ Ft. from E. Line

990 Ft. from W. Line

Location \_\_\_\_\_

Rig up \_\_\_\_\_

Drilling and Remarks:

*POT-1069**Flowing***RECORD**Cased 7 in., 3654 ft.Sand Chats. 3654

Gas \_\_\_\_\_

Oil \_\_\_\_\_

Total Depth 3691**PRODUCTION**

1st 24 hrs. Nat. \_\_\_\_\_

1st 24 hrs. after shot \_\_\_\_\_

Gas \_\_\_\_\_ Cu. Ft.

Dry Hole \_\_\_\_\_

Abandoned \_\_\_\_\_

Date

JUL 14 1937 19

H. D. Hatfield

Scout