


Section 33 Township 31 Range 1-W

Well Number 5-Erker

Company Stelbar Oil

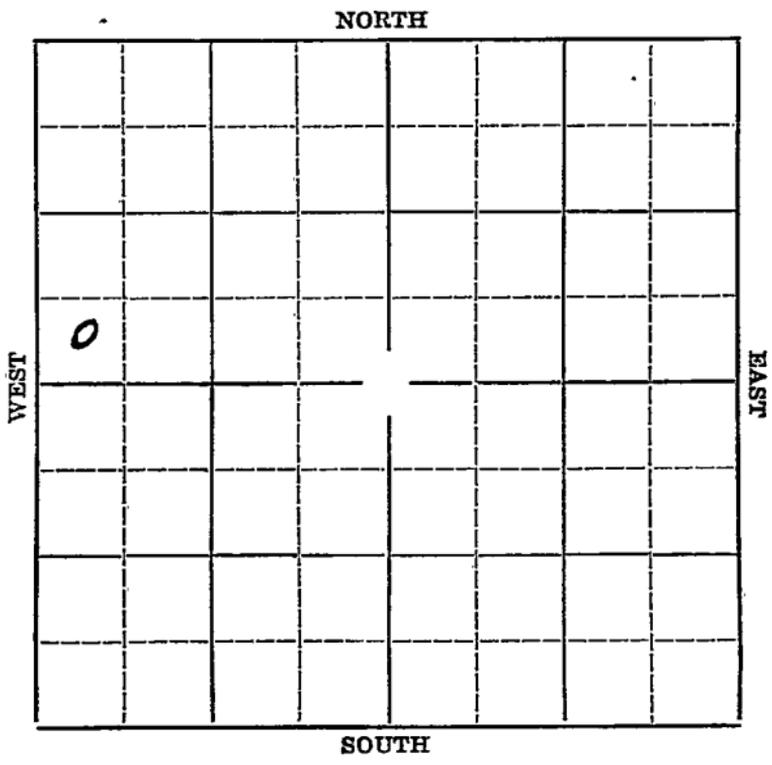

Map No. **KANSAS** Sec. **33** Twp. **31** R. **1-W**

Well No. **5-Erker** Farm


Stelbar Oil Company

_____ Ft. from N. Line

330 Ft. from S. Line

_____ Ft. from E. Line

330 Ft. from W. Line

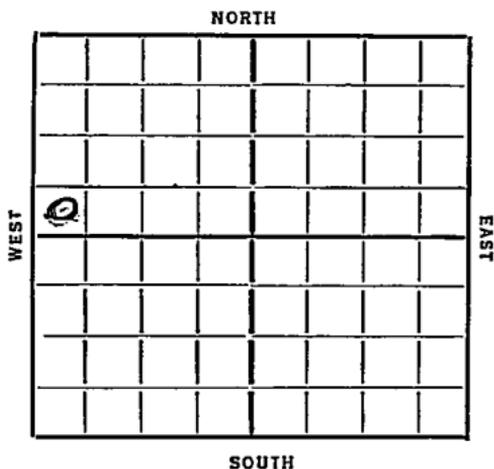

Date
1936

REPORT

5/27 Rigging up

6/11 Drig. 2360'.

7/8/36-Chat 3643'.

3000 gallons of acid.

T.D. 3685'.

624 bbls of oil.

COMPLETED

Map No. 31 Sec. 33 Twp. 21 R. 1W

Well No. 5 Er bar


Contractor

SECTION PLAT

_____ Ft. from N. Line

330 Ft. from S. Line

_____ Ft. from E. Line

330 Ft. from W. Line

FIRST REPORT'S

CORRECTION

Location _____

Rig up _____

Drilling and Remarks:

Rigging up

RECORD

Cased _____ in., _____ ft.

Sand _____

Gas _____

Oil _____

Total Depth _____

PRODUCTION

1st 24 hrs. Nat. _____

1st 24 hrs. after shot _____

Gas _____ Cu. Ft.

Dry Hole _____

Abandoned _____

Date

5/27/36 19

S. J. LEWIS

Scout

Map No. 31 Sec. 23 Twp. 21 R. 14Well No. 5 EkerStellar Company

Contractor

SECTION, PLAT

_____ Ft. from N. Line

330 Ft. from S. Line

_____ Ft. from E. Line

330 Ft. from W. Line

COMPLETED

Location _____

Rig up _____

Drilling and Remarks:

@ hole 36433000 acid6248 Y le

RECORD

Cased _____ in., _____ ft.

Sand _____

Gas _____

Oil _____

Total Depth 3695

PRODUCTION

1st 24 hrs. Nat. _____

1st 24 hrs. after shot _____

Gas _____ Cu. Ft.

Dry Hole _____

Abandoned _____

Date

JUL 8 1936

19

S. J. LEWIS

Scout