

KANSAS


Sumner

Form 51-5M-4-36-Palace

Section 33 Township 31 Range 1-W

Well Number 6-Erker

Company Stelbar Oil

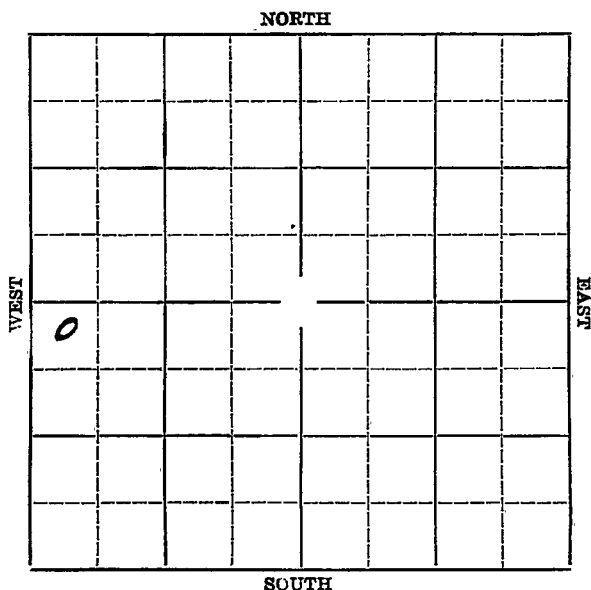

KANSAS

Map No. 31 Sec. 22 Twp. 21 R. 1WWell No. 6 - EckerStellar Oil Company

Contractor

SECTION PLAT

0			

330 Ft. from N. Line

_____ Ft. from S. Line

_____ Ft. from E. Line

330 Ft. from W. Line

FIRST REPORT

Location _____

Rig up _____

Drilling and Remarks:

Burrowing rig

RECORD

Cased _____ in., _____ ft.

Sand _____

Gas _____

Oil _____

Total Depth _____

PRODUCTION

1st 24 hrs. Nat. _____

1st 24 hrs. after shot _____

Gas _____ Cu. Ft.

Dry Hole _____

Abandoned _____

Date

JUN 17 1936

19

S. J. LEWIS

Scout

KANSAS

Map No. 31 Sec. 33 Twp. 21 R. 14Well No. 6 EkerStetson Oil Company

Contractor

SECTION PLAT

0			

330 Ft. from N. Line

_____ Ft. from S. Line

_____ Ft. from E. Line

330 Ft. from W. Line

COMPLETED

Location _____

Rig up _____

Drilling and Remarks:

Chas 36852000 acidPer 834 H

RECORD

Cased _____ in., _____ ft.

Sand _____

Gas _____

Oil _____

Total Depth 3625

PRODUCTION

1st 24 hrs. Nat. _____

1st 24 hrs. after shot _____

Gas _____ Cu. Ft.

Dry Hole _____

Abandoned _____

Date

AUG 12 1936 19

S. J. LEWIS Scout