

KANSAS


Form 51-5M 5-37 Petrol

Sumner

Section 33 Township 31 Range 1-W

Well No. 10 Erker

Company Stelbar

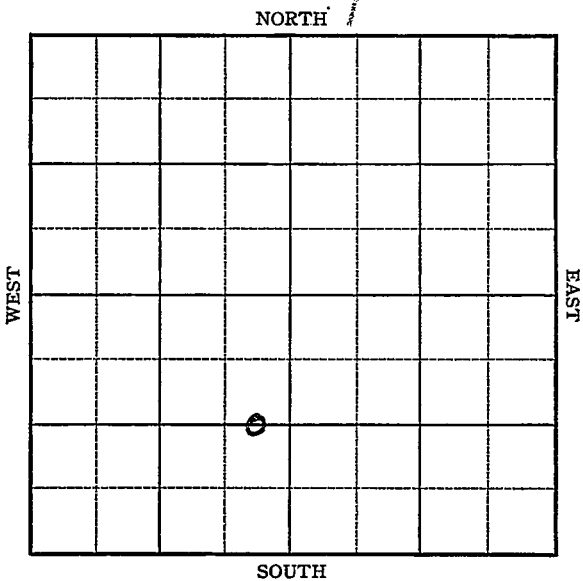

No 10 and well

Summer

Sec. 33 Twp. 31 R. 1-W

Well No. #10 Erker Farm
Stelbar Company


_____ Ft. from N. Line

1320 Ft. from S. Line

330 Ft. from E. Line

Ft. from W. Line

Elev. 1249'.

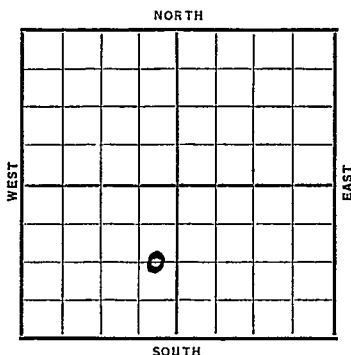

Date	REPORT
1937	
12/8	Mat'l.
12/17	10" @ 329'. WOC.
12/24	Drl g. 1760'.
12/31	Drl g. 2695'.
1938	
1/7	Drl g. 3600'.
1/14	Chat 3644'? 7" @ 3645'. WOC.
1/19	7" @ 3645'.
	Chat 3644'.
	T.D. 3684'.
	4000 acid.
	Potential 1066 bbls., flowing.
	COMPLETED

Map No. 31 Sec. 33 Twp. 31 R. 1WWell No. 10 ErkerStelbar Company Contractor

FIRST REPORT

C E L SW

 Ft. from N. Line1320 Ft. from S. Line330 Ft. from E. Line Ft. from W. Line

SECTION PLAT

Location Rig up

Drilling and Remarks:

Matl.

RECORD

Cased in., ft.Sand Gas Oil Total Depth

PRODUCTION

1st 24 hrs. Nat. 1st 24 hrs. after shot Gas Cu. Ft.Dry Hole Abandoned

Date

DEC 8 - 1937 19

H. D. Hatfield Scout

