


Section 33 Township 31 Range 1-W

Well Number #3-Erker

Company Stelbar Oil

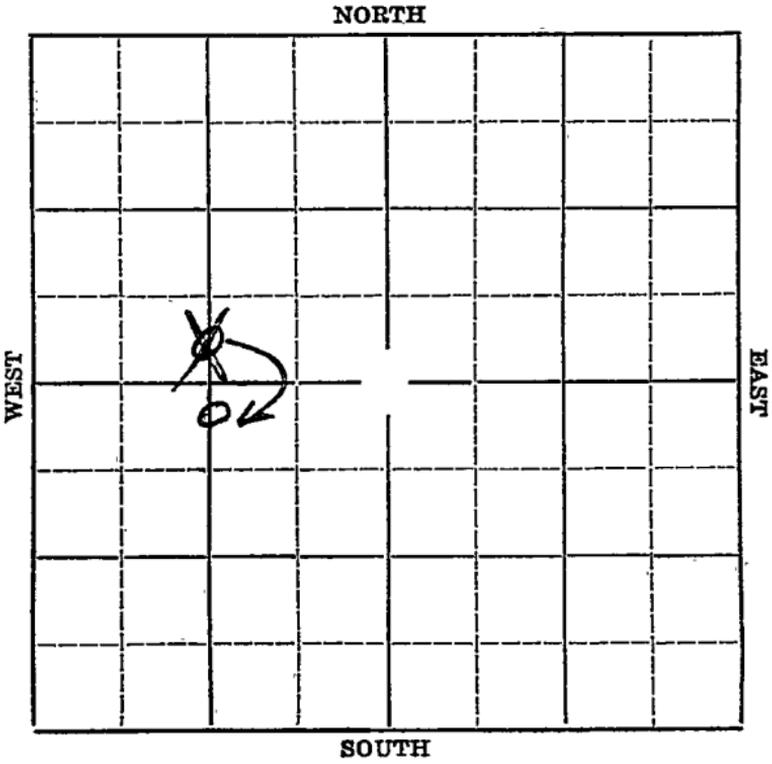

KANSAS

Form 26-1M Eks. 2-29

Map No. 31 Sec. 33 Twp. 31 R. 11W

Well No. 8 Eaker

Stelhar Oil Company

Contractor

SECTION PLAT

_____ Ft. from N. Line

330 Ft. from S. Line

_____ Ft. from E. Line

1320 Ft. from W. Line

FIRST REPORT

Location _____

Rig up _____

Drilling and Remarks:

16" @ 340 WOC

RECORD

Cased _____ in., _____ ft.

Sand _____

Gas _____

Oil _____

Total Depth _____

PRODUCTION

1st 24 hrs. Nat. _____

1st 24 hrs. after shot _____

Gas _____ Cu. Ft.

Dry Hole _____

Abandoned _____

Date

AUG 19 1936

S. J. LEWIS

Scout

KANSAS

Map No. 31 Sec. 33 Twp. 21 R. 1W

Well No. 10 Ecker

Stellar Oil Co. Company

Contractor

SECTION PLAT

	0		

830 Ft. from N. Line

_____ Ft. from S. Line

990 Ft. from E. Line

_____ Ft. from W. Line

FIRST REPORT

Location _____

Rig up _____

Drilling and Remarks:

Surface hole

RECORD

Cased _____ in., _____ ft.

Sand _____

Gas _____

Oil _____

Total Depth _____

PRODUCTION

1st 24 hrs. Nat. _____

1st 24 hrs. after shot _____

Gas _____ Cu. Ft.

Dry Hole _____

Abandoned _____

Date

NOV 10 1935 19

S. J. LEWIS Scout

KANSAS

Map No. 31 Sec. 33 Twp. 7 R. W.

Well No. T Erker

Stellar Oil Company

Contractor

SECTION PLAT

	o		

330 Ft. from N. Line

_____ Ft. from S. Line

1320 Ft. from E. Line

_____ Ft. from W. Line

CORRECTION

Location _____

Rig up _____

Drilling and Remarks:

*Reported on
No 8 in NW
NE SW.*

RECORD

Cased _____ in., _____ ft.

Sand _____

Gas _____

Oil _____

Total Depth _____

PRODUCTION

1st 24 hrs. Nat. _____

1st 24 hrs. after shot _____

Gas _____ Cu. Ft.

Dry Hole _____

Abandoned _____

Date
NOV 25 1936

Map No. 31 Sec. 33 Twp. 31 R. 1W

Well No. J Ecker

Stellar Oil Company

Contractor

SECTION PLAT

330 Ft. from N. Line

_____ Ft. from S. Line

1320 Ft. from E. Line

_____ Ft. from W. Line

	○		

COMPLETED

Location _____

Rig up _____

Drilling and Remarks:

*Chat 3624
1000 acid
4000 acid*

Pay 930

RECORD

Cased 2 in., _____ ft.

Sand _____

Gas _____

Oil _____

Total Depth 3680

PRODUCTION

1st 24 hrs. Nat. _____

1st 24 hrs. after shot _____

Gas _____ Cu. Ft.

Dry Hole _____

Abandoned _____

Date

DEC 29 1936 19

S. J. LEWIS Scout