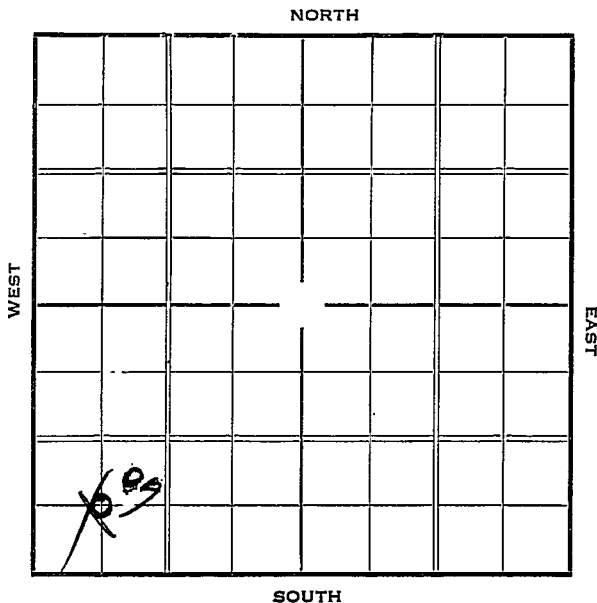


Section 33 Township 31 Range 1-WWell Number 17 - ErkerCompany Stelbar

Map No. 31 Sec. 33 Twp. 31 R. 1 ^WWell No. 17 - ErkerStelbar Company

Contractor

FIRST REPORT

SECTION PLAT

 Ft. from N. Line660 Ft. from S. Line Ft. from E. Line660 Ft. from W. Line

0			

Location Rig up

Drilling and Remarks:

Rat Rig

RECORD

Cased in., ft.Sand Gas Oil Total Depth

PRODUCTION

1st 24 hrs. Nat. 1st 24 hrs. after shot Gas Cu. Ft.Dry Hole Abandoned

Date

MAY 12 1937 19

H. D. Hatfield Scout

Map No. 31 Sec. 33 Twp. 31 R. 1 WWell No. 17-EnterStelbar Company

Contractor

CORRECTION

SECTION PLAT

0			

 Ft. from N. Line921 Ft. from S. Line Ft. from E. Line800 Ft. from W. LineLocation Rig up

Drilling and Remarks:

*First reported
as being
C SW SW*

RECORD

Cased in., ft.Sand Gas Oil Total Depth

PRODUCTION

1st 24 hrs. Nat. 1st 24 hrs. after shot Gas Cu. Ft.Dry Hole Abandoned

Date

MAY 19 1937

19

H. D. Hatfield

Scout

Map No. 31 Sec. 33 Twp. 31 R. 14Well No. 17 - ErkerStelbar Company

Contractor

CORRECTION

SECTION PLAT

0			

_____ Ft. from N. Line

921 Ft. from S. Line

_____ Ft. from E. Line

800 Ft. from W. Line

Location _____

Rig up _____

Drilling and Remarks:

Foot Measurements

First Reported

as 660 X 660

RECORD

Cased _____ in., _____ ft.

Sand _____

Gas _____

Oil _____

Total Depth _____

PRODUCTION

1st 24 hrs. Nat. _____

1st 24 hrs. after shot _____

Gas _____ Cu. Ft.

Dry Hole _____

Abandoned _____

Date

JUN 30 193

19

E. D. Hatfield

Scout

Map No. _____ Sec. 33 Twp. 31 R. 1 WWell No. 17-EnkerStelbar Company

Contractor _____

COMPLETED

SECTION PLAT

0			

_____ Ft. from N. Line

921 Ft. from S. Line

_____ Ft. from E. Line

800 Ft. from W. Line

Location _____

Rig up _____

Drilling and Remarks:

2000 A,
Pat - 1360
flow

RECORD

Cased 7 in., 3630 ft.Sand CHAT 3630

Gas _____

Oil _____

Total Depth 3671

PRODUCTION

1st 24 hrs. Nat. _____

1st 24 hrs. after shot _____

Gas _____ Cu. Ft.

Dry Hole _____

Abandoned _____

Date

JUN 30 1927H. D. Hargold Scout