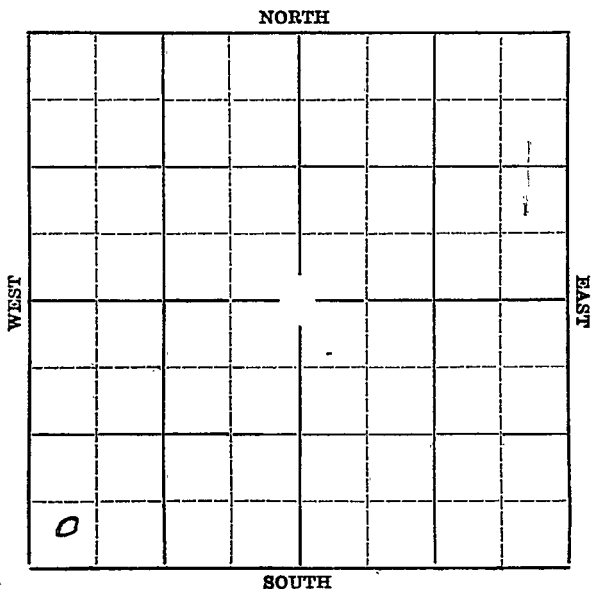
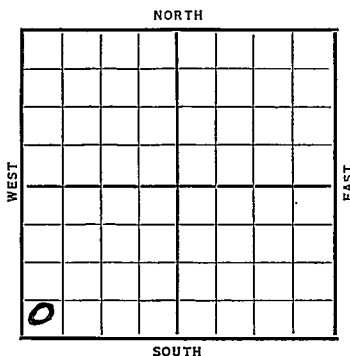


Section 33 Township 31 Range 1-WWell Number #13-ErkerCompany Stelbar Oil

Sec. 33 Twp. 31 R. 1WWell No. #13 Erker Farm
Stelbar Oil. Company Ft. from N. Line495' Ft. from S. Line Ft. from E. Line330' Ft. from W. Line

Elev. 1227

Date 1936

REPORT

9/9 Rigging up.9/18 10" @ 312'. Drlg. 900'.9/24 ~~XXXXXXXXXXXXXXXXXXXXXXXXXXXX~~

Drlg. 2510'.

10/1 Drlg. 3505'.10/8 Chat 3626'. 6" @ 3628'. Gas3645' oil 3655'. T.D. 3671'. F
Flowed 110 bbls in 10 hours.10/15 2000 gallons of acid. Testing.10/21/36 Chat 3626'.

T.D. 3671'.

3000 gallons of acid.

Potential 1617 bbls of oil.

COMPLETED

KANSAS

Form 26-1M Bks. 2-29

Map No. 31 Sec. 33 Twp. 31 R. 1WWell No. 13 EckerStetson Oil Company

Contractor

SECTION PLAT

 Ft. from N. Line495 Ft. from S. Line Ft. from E. Line330 Ft. from W. Line

FIRST REPORT

Location Rig up

Drilling and Remarks:

Rigging up

RECORD

Cased in., ft.Sand Gas Oil Total Depth

PRODUCTION

1st 24 hrs. Nat. 1st 24 hrs. after shot Gas Cu. Ft.Dry Hole Abandoned

Date

SEP 9 1936

19

S. J. LEWIS

Scout

Sumner
 Map No. 31 Sec. 33 Twp. 31 R. 1W

Well No. 13 Erker

Stellar Company

Contractor

SECTION PLAT

_____ Ft. from N. Line

495 Ft. from S. Line

_____ Ft. from E. Line

330 Ft. from W. Line

COMPLETED

RECORD

Location _____

Cased _____ in., _____ ft.

Rig up _____

Sand _____

Drilling and Remarks: "

Gas _____

Qha 83626

Oil _____

Total Depth 8671

3000 acid

PRODUCTION

1st 24 hrs. Nat. _____

1st 24 hrs. after shot _____

Gas _____ Cu. Ft.

Dry Hole _____

Abandoned _____

Pd 1617

Date

OCT 21 1936

19

S. J. LEWIS Scout