


Section 33 Township 31 Range 1W

Well Number 16 Erker

Company Stelbar

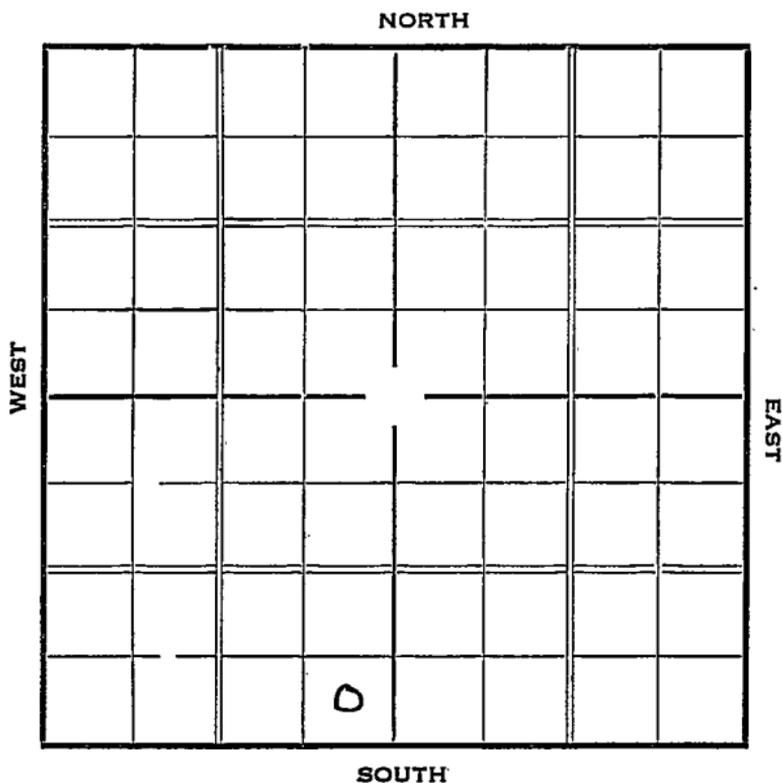

Sec. 33 Twp. 31 R. 1-W


Well No. #16 Erker Farm
Stelbar Company

 Ft. from N. Line

330 Ft. from S. Line

330 Ft. from E. Line

 Ft. from W. Line

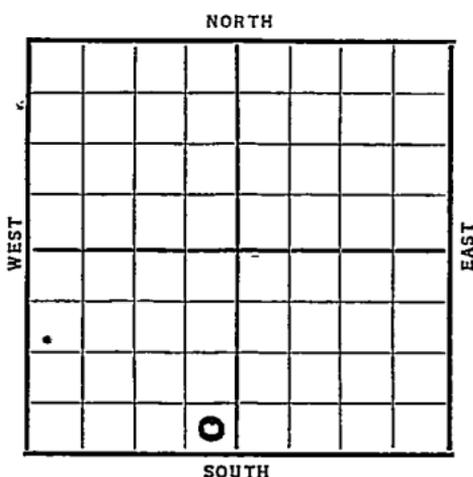

Date	REPORT
1937	
1/20	Location
1/28	"
2/4	"
2/11	Cellar
2/18	"
2/26	"
3/4	ROG.
3/11	"
3/18	Rig
3/25	"
4/2	"
4/8	Spud
4/16	10" @ 330'. Drlg. 900'.
4/23	K C Lime 3030'.
	Drlg. 3100'.
4/30	Chat 3649'. 7" @ 3650'. T.D.
	WOC.
5/7	T.D. 3706'. Flowed 167 oil
	2000 acid.
	OVER

1937

5/12 7" @ 3661'.

Chat 3660' (Corrected)

T.D. 3706'.

2000 acid.

Flowed 1274 bbls. 24 hrs.

COMPLETED

Map No. 31 Sec. 33 Twp. 31 R. 1W.

Well No. 16 Esper.

Stellar Company

Contractor

SECTION PLAT

_____ Ft. from N. Line

330 Ft. from S. Line

330 Ft. from E. Line

_____ Ft. from W. Line

FIRST REPORT

Location ✓

Rig up _____

Drilling and Remarks:

RECORD

Cased _____ in., _____ ft.

Sand _____

Gas _____

Oil _____

Total Depth _____

PRODUCTION

1st 24 hrs. Nat. _____

1st 24 hrs. after shot _____

Gas _____ Cu. Ft.

Dry Hole _____

Abandoned _____

Date

JAN 20 1937

19

S. J. LEWIS

Scout

Map No. 31 Sec. 33 Twp. 3 / R. 1

Well No. 16-Enker

Stelbar Company

Contractor

COMPLETED

SECTION PLAT

_____ Ft. from N. Line

330 Ft. from S. Line

330 Ft. from E. Line

_____ Ft. from W. Line

Location _____

Rig up _____

Drilling and Remarks:

2000 Acid

Flowed 1274/24 hrs

RECORD

Cased 7 in., 3661 ft.

Sand CHAT- 3660

Gas _____ (Corrected)

Oil _____

Total Depth 3706'

PRODUCTION

1st 24 hrs. Nat. _____

1st 24 hrs. after shot _____

Gas _____ Cu. Ft.

Dry Hole _____

Abandoned _____

Date

MAY 12 1937

H. D. Hatfield

Scout