
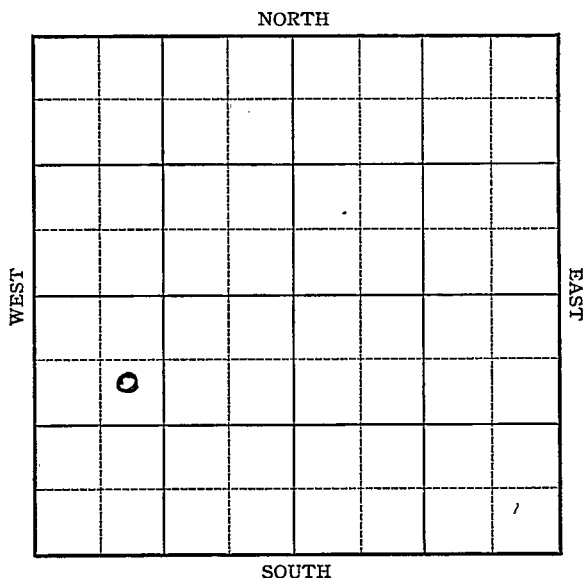


Section 33 Township 31 Range 1-WWell No. 18 ErkerCompany Stelbar

Sec. 33 Twp. 31 R. 1-WWell No. #18 Erker Farm
Stelbar Company800 Ft. from N. Line Ft. from S. Line Ft. from E. Line850 Ft. from W. Line

Elev. 1235'.

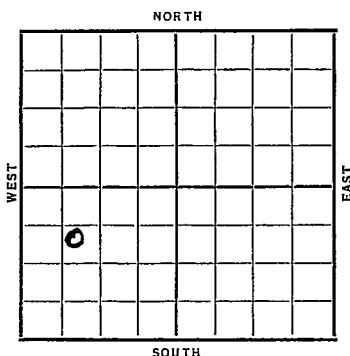

Date	REPORT
1938	
1/19	10" @ 325'.
	Drlg. 1380'.
1/28	Drlg. 2581'
2/4	Drlg. 3410'
2/11	Chat 3625'. T.D. 3626'.
	7" @ 3625'. RUST.
	No shows reported.
2/18	" " " "
2/26	" " " "
3/4	" " " "
3/11	" " " "
3/18	" " " "
3/25	" " " "
4/1	Shut down.
4/8	" "
4/15	" "
4/22	" "
4/29	" "
5/6	" "
5/12	" "

OVER

1938

5/20 SD 3625'.

5/27 " "

6/3 " "

6/10 " "

6/17 " "

6/24 " "

6/29 Chat. 3625 7" 3625

T.D. 3661

5000 acid

Flowed 8 1/4 & 90/4

Pot. 486

COMPLETED

Sumner KANSASMap No. 31 Sec. 33 Twp. 31 R. 1WWell No. 18 ErkerStelbar

Company

Contractor

FIRST REPORT

SE NW SW

800 Ft. from N. Line

_____ Ft. from S. Line

_____ Ft. from E. Line

850 Ft. from W. Line**SECTION PLAT**

0			

Location _____

Rig up _____

Drilling and Remarks:

10" - 325Drilling 1380**RECORD**

Cased _____ in., _____ ft.

Sand _____

Gas _____

Oil _____

Total Depth _____

PRODUCTION

1st 24 hrs. Nat. _____

1st 24 hrs. after shot _____

Gas _____ Cu. Ft.

Dry Hole _____

Abandoned _____

Date

JAN 19 1938

19

H. D. Hatfield

Scout

John.

Returned	
Cards	<i>Paul</i>
Tracing	<i>John</i>
France Map	<i>John</i>
Scarborough Map	<i>John</i>
Moody Map	
Scarborough Flat Book	
Moody Flat Book	

Summer

KANSAS

Map No. 31 Sec. 33 Twp. 31 R. 1WWell No. 18 ErkerStelbar

Company

Contractor

COMPLETED

SECTION PLAT

0			

SE NW SW

800 Ft. from N. Line

_____ Ft. from S. Line

_____ Ft. from E. Line

850 Ft. from W. Line

Location _____

Rig up _____

Drilling and Remarks:

5000 acid
flowed 8 1/4 x 9 1/4
ROT 486

RECORD

Cased 7 in., 3625 ft.Sand Chat 3625

Gas _____

Oil _____

Total Depth 3661

PRODUCTION

1st 24 hrs. Nat. _____

1st 24 hrs. after shot _____

Gas _____ Cu. Ft.

Dry Hole _____

Abandoned _____

Date

JUN 29 1938

19

H. D. Hatfield Scout

RAY

Returned	RAY
Cards	RAY
Tracing	RAY
France Map	RAY
Scarborough Map	RAY
Moody Map	RAY
Scarborough Flat Book	RAY
Moody Flat Book	RAY