


Map No. KANSAS Sec. 33 Twp. 31 R. 1W

Well No. 2 Pessel
Click, Poppel Lockhart & Derby Farm
 Company

NORTH

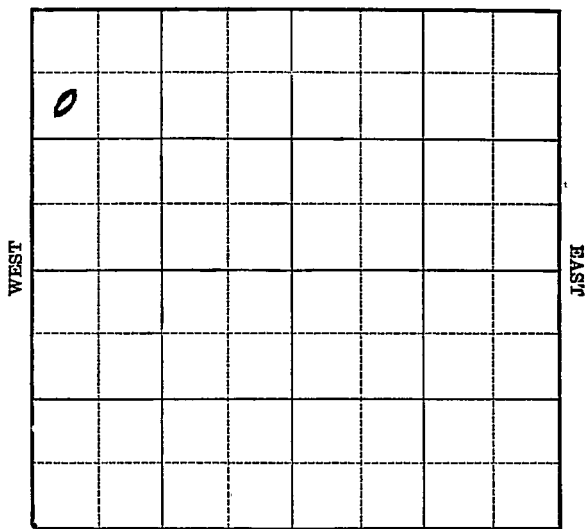

SOUTH

Location _____

Drilling Remarks _____

Rig Up _____

Drilling Remarks _____

RECORD

Cased _____ in. _____ ft.

Sand _____

Gas _____

Oil _____

Total Depth _____

PRODUCTION

1st 24 hrs. Nat. _____

1st 24 hrs. after shot _____

Gas _____ cu. ft.

Dry Hole _____

Abandoned _____

Summer

Map No. KANSAS Sec. 33 Twp. 31 R. 1W


Well No. 2 Pencil
Slick, Puyot Lockhart & Derby Farm
Company

990 Ft. from N. Line

_____ Ft. from S. Line

_____ Ft. from E. Line

330 Ft. from W. Line

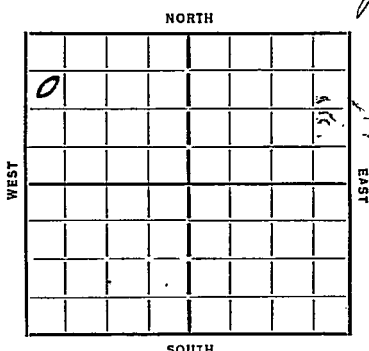

Date 1934 REPORT

12/76 Location
1/3/38 — 1/10 —
1/17 B. R.
1/24 —
1/31 Alg 103
2/7 " 460
2/14 " 1865
2/21 " 3111
2/28 " 3656
3/7 Chat 3660 5" 3660 Rust
3/14 3664 5" S.O.
3/21 3689 1000 acid W.O.F.
3/28 Reacidize
4/3 Chat 3660 T7 3689
1000 acid 303 Bbls.

COMPLETED

Map No. 31 Sec. 33 Twp. 31 R. 1W

Well No. 2 - Pease

Slick Pease & Lockhart + Darby Company

Contractor

FIRST REPORTS

990 Ft. from N. Line

..... Ft. from S. Line

..... Ft. from E. Line

330 Ft. from W. Line

SECTION PLAT

0			

Location ✓

Rig up

Drilling and Remarks:

RECORD

Cased.....in.,ft.

Sand.....

Gas.....

Oil.....

Total Depth.....

PRODUCTION

1st 24 hrs. Nat.....

1st 24 hrs. after shot.....

Gas.....Cu. Ft.

Dry Hole.....

Abandoned.....

Date

12-26-34 192..... ORVAL MANNSCHRECK Scout



Map No. 31 Sec. 33 Twp. 31 R. 1WWell No. 2 - PearlClick payor + Lockhart Company

Contractor

COMPLETED

SECTION PLAT

990 Ft. from N. Line

Ft. from S. Line

Ft. from E. Line

330 Ft. from W. Line

0			

Location

Rig up

Drilling and Remarks:

100 sand303 ft

RECORD

Cased in. ft.

Sand Chat 3660

Gas

Oil

Total Depth 3689

PRODUCTION

1st 24 hrs. Nat.

1st 24 hrs. after shot

Gas Cu. Ft.

Dry Hole

Abandoned

ORVAL MANNSCHRECK

Date

4-3-35 192 Scout

Return

Cards

Tracing

France Map

Scarborough

Moody Map

Scarborough Plot Book

Moody Plot Book