

Summer

Map No. KANSAS Sec. 33 Twp. 31 R. 10

Well No. 3- Pencil Farm

Rich Pryor & L Company


990 Ft. from N. Line

_____ Ft. from S. Line

_____ Ft. from E. Line

1320 Ft. from W. Line

Elev. 1253

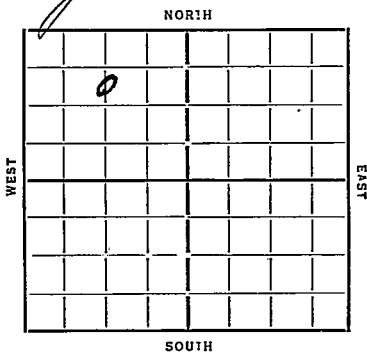

Date 1935 REPORT

8/21 Rgn

8/29 15" 335

9/6 dly 1170

10/3 TC 3652 6" 3648

10/10 dly 3682

10/10 Oil 3660-83 TD

10/17 1000 acid

10/17 Chat 3657

10/17 TD 3683

10/17 1000 acid

10/17 639 Bbls.

COMPLETED

Map No. 31 Sec. 33 Twp. 31 R. 1W

Well No. 3-Prasec

Slip print & [unclear] Company

Contractor

FIRST REPORTS

SECTION PLAT

990 Ft. from N. Line

..... Ft. from S. Line

..... Ft. from E. Line

1320 Ft. from W. Line

0			

Location.....

Rig up.....

Drilling and Remarks:

RECORD

Cased..... in., ft.

Sand.....

Gas.....

Oil.....

Total Depth.....

PRODUCTION

1st 24 hrs. Nat.....

1st 24 hrs. after shot.....

Gas..... Cu. Ft.

Dry Hole.....

Abandoned.....

Reg n

Date

8-21-35 192.....

Scout

Map No. 31 Sec. 33 Twp. 31 R. 1W

Well No. 3-Pearce

Slack, Ryan & L Company

Contractor

COMPLETED

SECTION PLAT

990 Ft. from N. Line

..... Ft. from S. Line

..... Ft. from E. Line

1320 Ft. from W. Line

	0		

RECORD

Location.....

Cased..... in..... ft.

Rig up.....

Sand Chat 3657

Drilling and Remarks: .

Gas.....

1000 and

Oil.....

639 H₂O

Total Depth 3683

PRODUCTION

1st 24 hrs. Nat.....

1st 24 hrs. after shot.....

Gas..... Cu. Ft.

Dry Hole.....

Abandoned.....

Date

10-17-35 192

MANNSCHRECK
Scout