

Map No. KANSASSec. 33Twp. 31R. 1WWell No. 6-Persel

Farm

Company

NORTH

WEST

EAST

SOUTH

Location

Drilling Remarks

Rig Up

Drilling Remarks

RECORD

Cased _____ in. _____ ft.

Sand _____

Gas _____

Oil _____

Total Depth _____

PRODUCTION

1st 24 hrs. Nat. _____

1st 24 hrs. after shot _____

Gas _____ cu. ft.

Dry Hole _____

Abandoned _____

Well No. 6-Plank Farm

Well No. 6-Plank Farm
Nick, Pryor & Lockhart Company

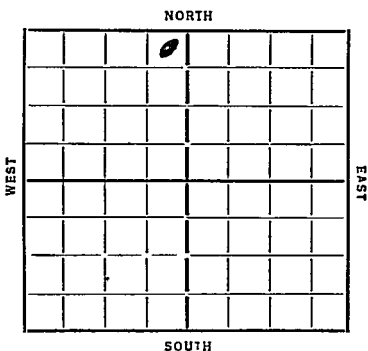
330 Ft. from N. Line.

Ft. from S. Line

330 Ft. from E. Line

Ft. from W. Line

Elev. 1245

Date 1/25/78 REPORT

1937	Location
11/20	

1/1/29, —

1/2/6 King

12/13 12^h 320

12/19 2500

12/21 3625

10/36 Geo Chat 2628 7024/38

7/11/10 7:10 36.71 1000 acid

40 Bbls Oil per hr 7 hrs

1 2000 acib wof

11/15 Chat 3628

TD 3671

	1000 acid
--	-----------

2000

651 Bble.

COMPLETED

KANSAS

Map No. 31 Sec. 33 Twp. 31 R. 1WWell No. 6- ReeseSlick, Pryor & Lockhart Company

Contractor

SECTION PLAT

	0		

330 Ft. from N. Line

Ft. from S. Line

330 Ft. from E. Line

Ft. from W. Line

Location ✓

Rig up

Drilling and Remarks:

RECORD

Cased.....in.,ft.

Sand.....

Gas.....

Oil.....

Total Depth.....

PRODUCTION

1st 24 hrs. Nat.....

1st 24 hrs. after shot.....

Gas.....Cu. Ft.

Dry Hole.....

Abandoned.....

Date

MANN SCHRECK

11-20-35 192

Scout

Map No. 31 Sec. 33 Twp. 31 R. 14Well No. 6-PraseStink-pyros & Lockhart Company

Contractor

COMPLETE

330 Ft. from N. Line

Ft. from S. Line

330 Ft. from E. Line

Ft. from W. Line

SECTION PLAT

	0		

Location

Rig up

Drilling and Remarks:

1000 acid
2000 acid
651 bbls

RECORD

Cased in, ft.

Sand Chert 3628

Gas

Oil

Total Depth 3671

PRODUCTION

1st 24 hrs. Nat.

1st 24 hrs. after shot

Gas Cu. Ft.

Dry Hole

Abandoned

Date

ORVAL MANN

1-15-36 192

Scout