


Harper

KANSAS

SECTION 33 TOWNSHIP 31S RANGE 5W

WELL NO. #2 Ioerger

COMPANY Natural Gas & Oil

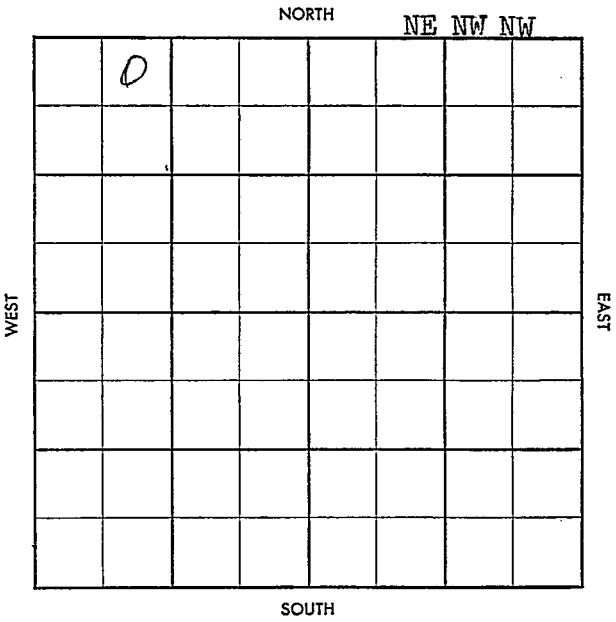

~~Production~~ ~~Field~~
~~Company~~ ~~Field~~

 Sec. 33 Twp. 31 Rge. 5W
 Company Natural Gas & Oil
 Farm Name Toerger No. 2


TOPS	DEPTH	LOG	DATUM
Anh.			
Tp.			
H.			
Tr.			
Dg.			
B.L.			
L.			
K.C.			
B.K.C.			
Ce.			
C.			
M.			
M.			
K.			
Mz.			
Mq.			
V.			
S.			
S.			
A.			
R.			
Pf.			
G.			
T.D.			

Loc. in Sec. _____
NE NW NW
 Geol. _____
 Contr. _____
S & S Drilg.
 Pool _____
Garber

APR 30 58
FIRST REPORT

Date Comm. 4-25-58
10" @ 317/250 drilg. 1735

Co. No. 1 Sec. No. T. R.

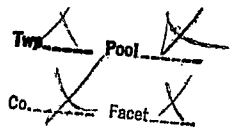

S-513-B

County Harper Elev 1339' - 1342' AB
 Sec. 33 Twp. 31 Rge. 5W
 Company Natural Gas & Oil
 Farm Name Ioerger No. 2

TOPS	DEPTH	LOG	DATUM
Anh. #			
Tp.			
H.			
Tr.			
Dg.			
B.L.			
L.			
K.C.	<u>3587</u>		
B.K.C.	<u>3914</u>		
Ce. <u>Marion</u>	<u>3892</u>		
C.			
M.	<u>4209</u>		
M.			
K.	<u>4549</u>		
Mz.			
Mq.			
V.			
S.	<u>4652</u>		
S.			
A.			
R.			
Pf.			
G.			
T.D.	<u>4696</u>		

Loc. in Sec. NE NW NW
 Geol. _____
 Contr. _____
 S & S Drilg. _____
 Pool _____
 Gerber

COMPLETE
 JUN 1 58

Date Comm. 4-25-58
10" @ 317/250 drlg. 1735 MAY 7 '58

DST 3760-70 1hr 200 SW
5 cum oil 15HP 1600 120 φ
3917 MAY 14 '58 4498 MAY 21 '58 DST 4654
-67 1hr 5/10" test 1440' ground
trw 1440 casing 60" SW FP
345-115 BHP 1750 120" DST 4667
-96 op/hr 645' HOG row 240' SOB 90
SW FP 135-430 BHP 1790 5" 4695
Log MAY 28 '58 CO 4 679

Co.
 Loc.
 No.
 Sec.
 T.
 R.

40/4654-58 5942 FU 700'

Fld lbr \$ 64B + 16BW 5hrs

nat T&R POP JUN 3 '58 JUN 11 '58

PhyP 132B0 + 132BW

S 4654-58

55-96

(Handwritten mark)

33-31-50

re new new