

Jud

STATE CORPORATION COMMISSION OF KANSAS
OIL & GAS CONSERVATION DIVISION
WELL COMPLETION OR RECOMPLETION FORM
ACO-1 WELL HISTORY
DESCRIPTION OF WELL AND LEASE

5

API NO. 15-.....175-20,971.....

County.....Seward.....

.....C. SW NE SW NE Sec. 9. Twp. 31 S Rge. 34 East
..... X West

.....3480..... Ft North from Southeast Corner of Section

.....1800..... Ft West from Southeast Corner of Section

(Note: Locate well in section plat below)

Lease Name SANTA FE "C".....Well #.....1.....

Field Name.....Wildcat.....

Producing Formation.....MORROW.....

Elevation: Ground.....2838.8.....KB.....NA.....

Operator: License #4549.....
Name ..Anadarko Petroleum Corporation..
Address ..P. O. Box 351.....
City/State/Zip Liberal, Kansas 67905-0351

Purchaser Oil: JM Petroleum.....
Gas: Panhandle Eastern Pipeline..

Operator Contact Person M. L. Reese.....
Phone 316-624-6253.....

Contractor: License # ...5842.....
Name ...Gabbert-Jones, Inc.....

Wellsite Geologist..Charles Isbon.....
Phone.....

Designate Type of Completion
 New Well Re-Entry Workover
 Oil SWD Temp Abd
 Gas Inj Delayed Comp.
 Dry Other (Core, Water Supply etc.)

If ONWQ: old well info as follows:
Operator
Well Name
Comp. DateOld Total Depth.....

WELL HISTORY

Drilling Method:
 Mud Rotary Air Rotary Cable


...8/31/87.. ...9/9/87.... ..10/31/87...
Spud Date Date Reached TD Completion Date

.....5740..... ..5470.....
Total Depth PBTD

Amount of Surface Pipe Set and Cemented at 162 feet
Multiple Stage Cementing Collar Used? Yes No
If yes, show depth set....2825.....feet
If alternate 2 completion, cement circulated
from.....feet depth to.....w/.....SX cmt
Cement Company Name
Invoice #

RECEIVED
STATE CORPORATION COMMISSION

Section Plat

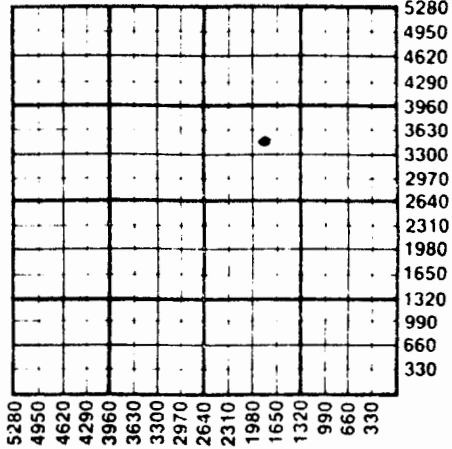

WATER SUPPLY INFORMATION

Disposition of Produced Water: Disposal
Docket # Repressuring

Questions on this portion of the ACO-1 call:

Water Resources Board (913) 296-3717

Source of Water:
Division of Water Resources Permit #.....

Groundwater.....Ft North from Southeast Corner
(Well)Ft West from Southeast Corner of
Sec Twp Rge East West

Surface Water.....Ft North from Southeast Corner
(Stream, pond etc).....Ft West from Southeast Corner
Sec Twp Rge East West

Other (explain) Drilling contractor furnished
water. (purchased from city, R.W.D. #)

INSTRUCTIONS: This form shall be completed in triplicate and filed with the Kansas Corporation Commission, 200 Colorado Derby Building, Wichita, Kansas 67202 within 120 days of the spud date of any well. Rule 82-3-130, 82-3-107 and 82-3-106 apply.

Information on side two of this form is confidential for a period of 12 months if requested in writing and submitted with the form. See Kansas-107 for confidentiality in excess of 12 months.

One copy of all wireline logs and drillers time log shall be attached with this form. Submit CP-4 form with all plugged wells. Submit CP-111 form with all temporarily abandoned wells.