SIDE ONE

STATE CORPORATION COMMISSION OF KANSAS
OIL & GAS CONSERVATION DIVISION
WELL COMPLETION OR RECOMPLETION FORM
ACO-1 WELL HISTORY
DESCRIPTION OF WELL AND LEASE

Operator: License # 5003
Name McCoy Petroleum Corporation
Address 110 S. Main, Suite 500
City/State/Zip Wichita, Kansas 67202

Purchaser

Operator Contact Person Roger McCoy
Phone (316) 265-9697

Contractor: License # 5658
Name Sweetman Drilling, Inc.

Wellsite Geologist Bob O'Dell
Phone (316) 265-9697

Designate Type of Completion
X New Well ___ Re-Entry ___ Workover
___ Oil ___ SWD ___ Temp Abd
___ Gas ___ Inj ___ Delayed Comp.
X Dry ___ Other (Core, Water Supply etc.)
If OWWO: old well info as follows:
Operator
Well Name
Comp. Date Old Total Depth

WELL HISTORY

Drilling Method:
X Mud Rotary ___ Air Rotary ___ Cable

10-02-88	11-14-88	11-14-88
Spud Date	Date Reached TD	Completion Date
5750'		
To Depth	PBTD	

Amount of Surface Pipe Set and Cemented at 1611 feet
Multiple Stage Cementing Collar Used? ___ Yes X No
If yes, show depth set feet
If alternate 2 completion, cement circulated
from feet depth to w/ SX cmt
Cement Company Name
Invoice #

API NO. 15- 175-21,049

County Seward

C NW SW Sec. 35 Twp. 31 Rge. 34 ___ East X West

1980 Ft North from Southeast Corner of Section
4620 Ft West from Southeast Corner of Section
(Note: Locate well in section plat below)


Lease Name Conover "A" Well # 1-35

Field Name Silverman Field

Producing Formation

Elevation: Ground 2752 KB 2762

Section Plat

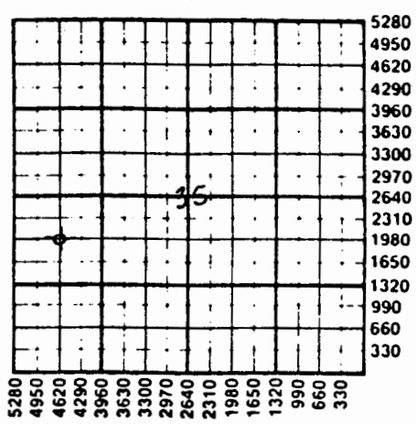

WATER SUPPLY INFORMATION

Disposition of Produced Water: ___ Disposal
Docket # ___ Repressuring

Questions on this portion of the ACO-1 call:
Water Resources Board (913) 296-3717
Source of Water:
Division of Water Resources Permit # T88-525

X Groundwater 2130 Ft North from Southeast Corner
(Well) 4695 Ft West from Southeast Corner of
Sec 35 Twp 31 Rge 34 ___ East X West

___ Surface Water Ft North from Southeast Corner
(Stream, pond etc) Ft West from Southeast Corner
Sec Twp Rge ___ East ___ West

___ Other (explain)
(purchased from city, R.W.D. #)

INSTRUCTIONS: This form shall be completed in triplicate and filed with the Kansas Corporation Commission, 200 Colorado Derby Building, Wichita, Kansas 67202, within 120 days of the spud date of any well. Rule 82-3-130, 82-3-107 and 82-3-106 apply.
Information on side two of this form will be held confidential for a period of 12 months if requested in writing and submitted with the form. See rule 82-3-107 for confidentiality in excess of 12 months.
One copy of all wireline logs and drillers time log shall be attached with this form. Submit CP-4 form with all plugged wells. Submit CP-111 form with all temporarily abandoned wells.

All requirements of the statutes, rules and regulations promulgated to regulate the oil and gas industry have been fully complied with and the statements herein are complete and correct to the best of my knowledge.

Signature Roger McCoy
Title President Date 10-15-88

Subscribed and sworn to before me this 15th day of November, 88.
Notary Public Deborah Ann Paulus
State Commission Expires January 8, 1992

DEBORAH ANN PAULUS
NOTARY PUBLIC
STATE OF KANSAS
My Appt. Exp. 1-8-92

K.C.C. OFFICE USE ONLY
F ✓ Letter of Confidentiality Attached
C ✓ Wireline Log Received
C ___ Drillers Timelog Received
Distribution
✓ KCC ___ SWD/Rep ___ NGPA
✓ KGS ___ Plug ___ Other
(Specify)

Sec. 35 Twp. 31 Rge. 34W

Form ACO-1 (5-86)

NOV 17 1988

KANSAS GEOLOGICAL SURVEY
WICHITA BRANCH