

Section 34 Township 31 Range 9 WWell No. # 2 DusenburyCompany E. F. Wakefield et al

NORTH

			0				

WEST

EAST

SOUTH

Harper KANSAS

SEC.	TWP.	R.
34	31	9W

WELL NO.

2 Dusenbury

FARM

COMPANY

E. F. Wakefield et al

CONTRACTOR

Co. Tools

Wildcat


330 Ft. from N. Line

Ft. from S. Line

330 Ft. from E. Line

Ft. from W. Line

NE NE NW

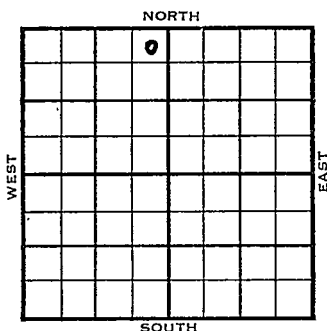

1954

ELEVATION

REPORT

1613'

10/13

Spud 10-7-54
8" @ 235'
Drlg. 2115'

1955
1/12

Spud 10-7-54 Oil well TD 4463
8" @ 235' Doug 3619 KC 3682
Miss 4422 DST 4422-37 open 1½ hr rec
180' O & GCM, 110' free oil, 90' wtr.
1200# TD 4463 5" @ 4463 Co
64/4422-38 S/8 BO 16 hr. S/25 GOPH
sd-oil-frac. 25 BOPD S/250 BO 15% wt
120 hr. P/30 BOPD 15% wtr. Comp. 40
BOPD 11 BW.

COMPLETED

County Harper State Kansas
 Sec. 34 (Blk. 31 (Sur. 9W Map No.
 (Twp.) (Rge.)
 Operator E. F. Wakefield et al.
 Well No. 2 Farm Dusenbury
 Elev. Location NE NE NW

			0			

330 Ft. From N Line NW
330 Ft. From E Line Quarter

1st. Report OCT 13 1954

Completion

Remarks

Co. tools

Spudding Date 10-7-54

Drlg. Data

Wildcat

8" @ 235 drlg. 2115

FABEN GILSTRAP

FABEN GILST. D