


DX 78-1 Harper

KANSAS

Section 34 Township 31 Range 9W

Well No. #1 Dusenbury Unit

Company Carter Oil

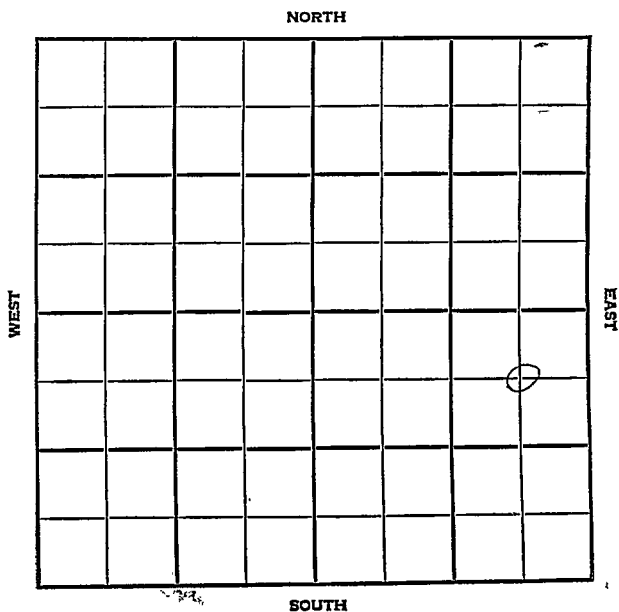

SEC.	TWP.	R.
34	31	9W

WELL NO.

#1 Dusenbury Unit

FARM

COMPANY

Carter Oil

CONTRACTOR

Wakefield

Grabs


____ FT. FROM N. LINE

____ FT. FROM S. LINE

610' FT. FROM E. LINE

____ FT. FROM W. LINE

C NE SE

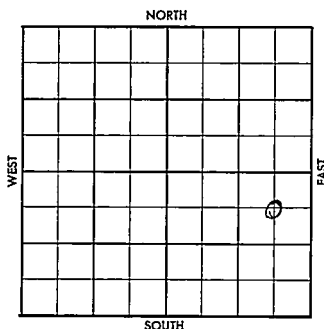

1956	ELEVATION	REPORT
	1592'	

7-11

Loc.

8-22

Comm. 7-15-56

8 5/8" @ 230 w/200

DST 4391-4410 op 80 min. gas in 1 min.

ga. 630 MCF; in 5 min. 1,930 MCF;

20 min. stabil. rec. 140' O&GCM /

67' oil gas & MCSW, BHP 1460/20".

DST 4412-27 op 2 hrs., gas in 54 min.

rec. 310' O&GCM / 60 G&OCMSW / 288'

GCSW, BHP 1070/20".

5 1/2" @ 4471 w/225

CO 4436

Pf 4386-94;

Flw 1,20 MCFG, 2 hrs., 1/2" chk;

FTP 150#. FCP 260#.

Flw 519 MCF; 2" tbg.

FTP 12#; FCP 140#;

ga 1,500 MCF; 3/4" chk; 1 hr.

FTP 100#. FCP 440#; Frac 5 x 5;

Flw 1d / ga 5,200 MCF; FCP 960#; 3/4" c

ga. 2,830 MCFG; 1/2" chk; / 60 BO

op flw; 6,036 MCFGPD / 60 BOPD

Log tops:

L. 3659'; KC. 3947'; M. 4386';

TD 4475'

COMPLETED

1 27

County Harney Elev. _____
Sec. 34 Twp. 31 Rge. 9W
Company Cartier Oil
Farm Name Disenbury Unit No. 1

TOPS	DEPTH	LOG	DATUM
Anh.			
Tp.			
H.			
Tr.			
Dg.			
Bl.			
L.			
K.C.			
B.K.C.			
Ce.			
C.			
M.			
M.			
K.			
Mz.			
Me.			
V.			
S.			
S.			
A			
R.			
Pe.			
G.			
T.D.			

Loc. in Sec. _____
C NE SE
610' EL
Geol. _____
Contr. _____
Wakefield
Pool _____
Grabs

FIRST REPORT		
		0
JUL 11 '36		

Date Comm. _____
Location

Conf d I
Q. R.

Co.
Lse.
No.
Sec.
T.
R.

 Sec. 34 Twp. 31 Rge. 7
 Company Carter Oil
 Farm Name Dusenbury Unit No. 1

TOPS	DEPTH	LOG	DATUM	Loc. in Sec.
Anh.				61' S
Tr.				61' I
Dg.				
Bl.				
L.		3659		
K.C.		3947		Geol.
B.K.C.				Contr.
Ce.				Unconsolidated
C.				
M.		4386		Pool
M.				Traps
K.				
Mz.				
Mo.				
V.				
S.				
S.				
A.				
R.				
PE.				
G.				
T.D.	4475			

COMPLETE

Date Comm.

AUG 22 1950

Location JUL 18 '56 MIR JUL 23 '56 7-15

- 56 85/8 230/200 1/2 2156

AUG 1 '56 1/2 3862 AUG 8 '56

DST 4391-4410. 80" 9/1" ga

630 MCF/5" 1,930 MCF/20"

stabil. rec 140' O&GCM + 67'

oil Gas & MCF SW BHP 1460/20

DST 4412-27 2 hrs 9/54" TSTM

rec. 310' O&GCM + 60 G&OCMSW

+ 288' GCSW BHP 1070/20
 5 1/2 4471/225 AUG 15 '56 CO 4436
 PF 4386-94 F/W 1.20 MCFG
 2 hrs 1/2" ch FTP 150 FCP
 260# F/W 519 MCF 2" Thg
 FTP 12# FCP 140# 1/2" ga
 1,500 MCF 3/4" ch 1 hr FTP 100
 FCP 440# FRAC 5x5 F/W Ld +
 ga 5,200 MCF FCP 960#
 3/4" ch. AUG 22 '56 ga. 2,830 MCFG
 1/2" ch + 60 B.O.? (new oil?)
 op F/W 6.036 MCFG PD
 + 60 Bopd