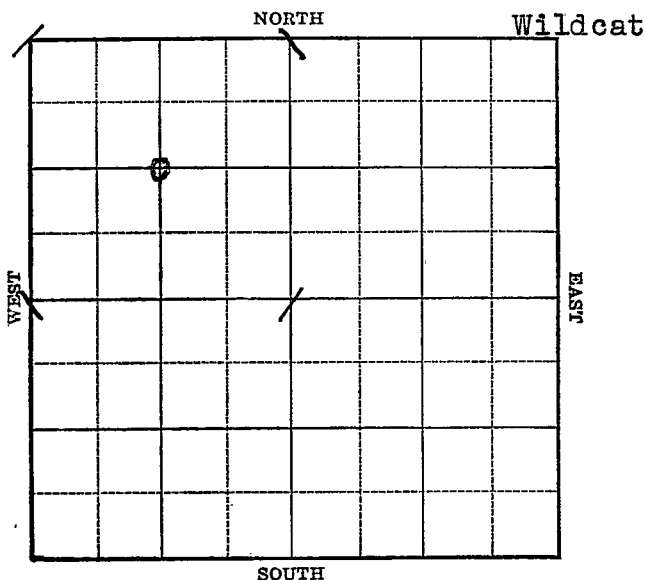


Stevens

KANSAS

Section 34 Township 31 Range 38-WWell No. #1 McClureCompany Colorado Gas Utility

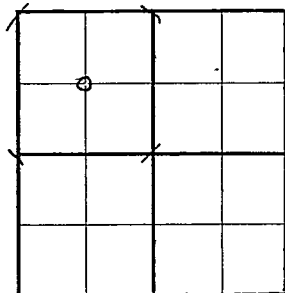
Stevens **KANSAS**Map No. _____ Sec. 34 Twp. 31 R. 38WWell No. 1 McClureColorado Gas Utility Company

Contractor _____

FIRST REPORT**C NW**1320 Ft. from N. Line

_____ Ft. from S. Line

_____ Ft. from E. Line

1320 Ft. from W. Line**WILDCAT****SECTION PLAT**

Location _____

Rig up _____

Drilling and Remarks:

Rig Rotary ;**RECORD**

Cased _____ in., _____ ft.

Sand _____

Gas _____

Oil _____

Total Depth _____

PRODUCTION

1st 24 hrs. Nat. _____

1st 24 hrs. after shot _____

Gas _____ Cu. Ft.

Dry Hole _____

Abandoned _____

Date

AUG 9 1939 19S. J. LEWIS Scout

Stevens KANSAS

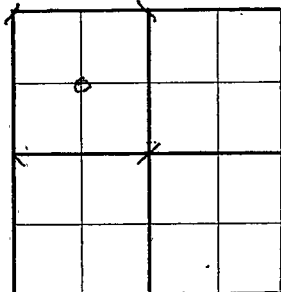
Map No. NM Sec. 34 Twp. 31 R. 38WWell No. 1 McClureColorado Gas Utility Company

Contractor

COMPLETED

C/NW

SECTION PLAT

1320 Ft. from N. Line Ft. from S. Line Ft. from E. Line1320 Ft. from W. Line

WILDCAT

Location Rig up

Drilling and Remarks:

*Sand 2447**7" C 2447**12000 acid**22 3/4 M Gas*

RECORD

Cased in., ft.Sand Gas Oil Total Depth 2525

PRODUCTION

1st 24 hrs. Nat. 1st 24 hrs. after shot Gas Cu. Ft.Dry Hole Abandoned

Date

SEP 6 1939 19

S. J. LEWIS Scout