


KANSAS

Seward County

Section 34 Township 31 Range 33W

Well No. #1 Fair

Company Stanolind

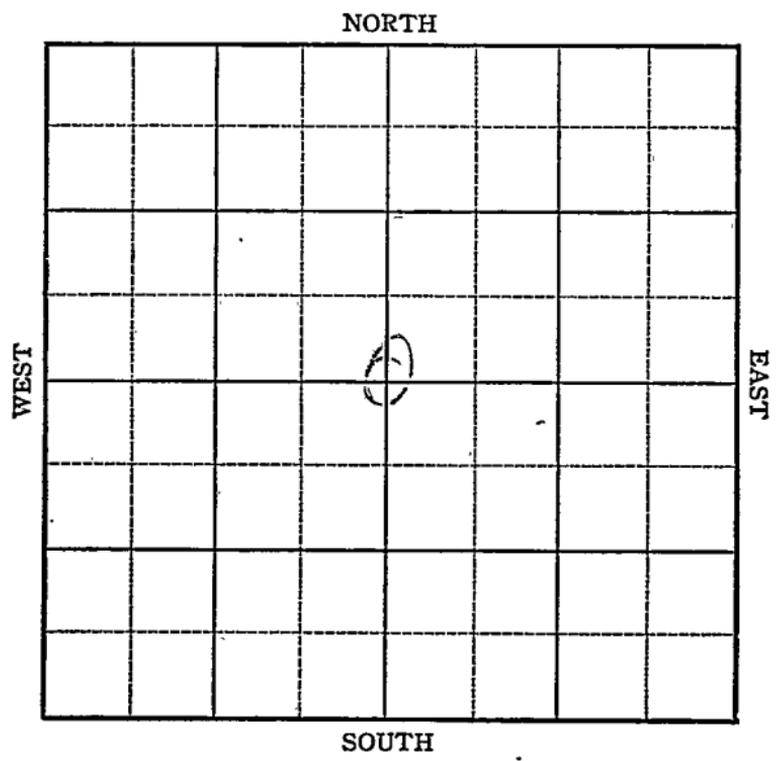

Sec. 34 Twp. 31 R. 33W

Well No. #1 Fair Farm _____
Stanolind Company _____

Hugoton


2640 Ft. from N. Line

_____ Ft. from S. Line

2640 Ft. from E. Line

_____ Ft. from W. Line

C Sec.

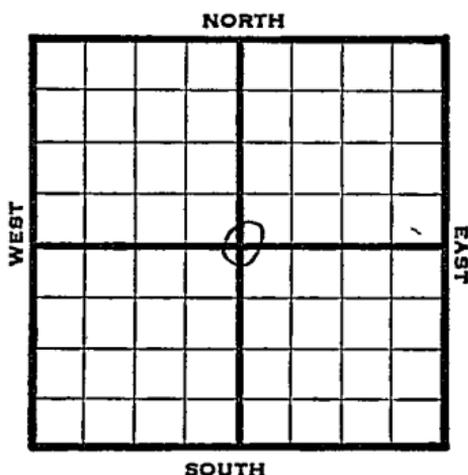

1946 2893 REPORT

7/24	Location
7/30	RUR
8/6	8" @ 692 Drlg 2287'
8/13	Drlg 2627'
8/20	TD 2755 5" @ 2727, RUST
8/27	" "
9/5	TD 2767'
9/10	144 shots 2650-2674, 12000 acid
9/18	" " "
9/24	90-shots 2624-39 4000 acid
10/2	5" @ 2727' Perf 16,000 acid 3,740,000 Gas TD 2767' 394# RPR

COMPLETED

KANSAS

Kansas Pool Name HugotonMap No. _____ Sec. 34 Twp. 31 R. 33WWell No. 1 FairStanolind Company

FIRST REPORT

Contractor

C Sec.


SECTION PLAT

2640 Ft. from N. Line

_____ Ft. from S. Line

2640 Ft. from E. Line

_____ Ft. from W. Line

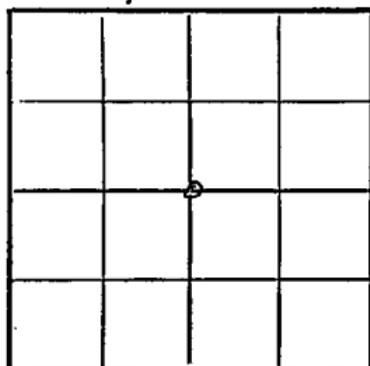

Seward County

Location X

Rig up _____

Drilling and Remarks:

RECORD

Cased _____ in., _____ ft.

Sand _____

Gas _____

Oil _____

Total Depth _____

PRODUCTION

1st 24 hrs. Nat. _____

1st 24 hrs. after shot _____

Gas _____ Cu. Ft.

Dry Hole _____

Abandoned _____

Date

JUL 24 1946 19S. J. LEWIS Scout

SESUEX
Kansas

Pool Name Hugoton Pool

KANSAS

Map No. 10 Sec. 34 Twp. 31 R. 33W

Well No. 1 Fair

Stanolind Company

COMPLETED

Contractor

C Sec.

E. 2727
SECTION PLAT

2640 Ft. from N. Line

_____ Ft. from S. Line

2640 Ft. from E. Line

_____ Ft. from W. Line

Seward County

Location _____

Rig up _____

Drilling and Remarks:

5" @ 2727

Prof

16000 acid

3,740,000 Sec

394 * R/A

RECORD

Cased _____ in., _____ ft.

Sand _____

Gas _____

Oil _____

Total Depth 2767

PRODUCTION

1st 24 hrs. Nat. _____

1st 24 hrs. after shot _____

Gas _____ Cu. Ft.

Dry Hole _____

Abandoned _____

Date

OCT 2 1946 19

S. J. LEWIS Scout