

Seward.

DX 78-1


KANSAS

Section 34 Township 31S Range 32W

Well No. #1 C.S. High

Company Skelly Oil Co.

NORTH

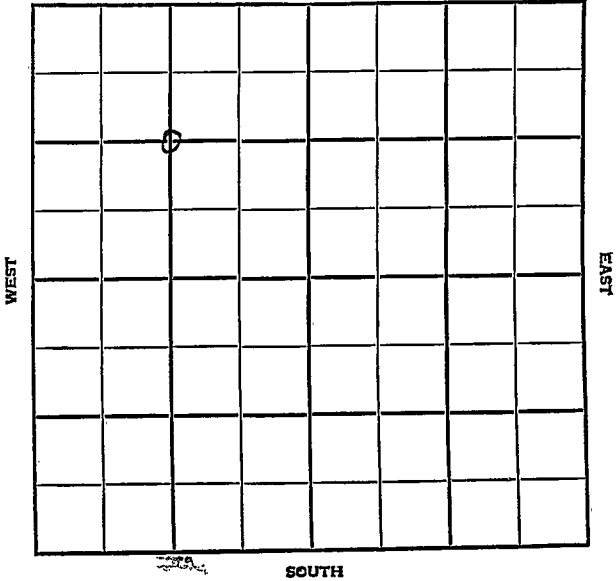

Seward

KANSAS

SEC.	TWP.	R.
34	31 S	32 W
WELL NO.		
# 1 G. S. High FARM		
COMPANY		
Skelly Oil Co.		
CONTRACTOR		
Nye & Snell		


1320 Ft. from N. Line

Ft. from S. Line

Ft. from E. Line

1320 Ft. from W. Line

C NW/4

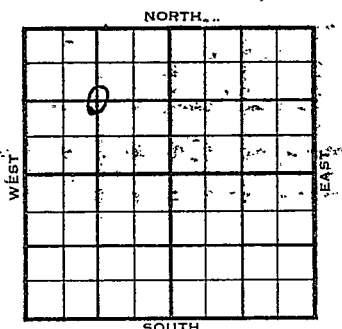

ELEVATION

REPORT

1954

2850'

12/8

Location

1955

2/16


Spud 12-8-54 Gas well TD 5861
 8" @ 715' Her. 2634' Kri. 2660'
 Win. 2742' Tow. 2790' Ft. Riley 2852'
 DST 4353-73 open 1 hr. rec 105' mud &
 SW 1100#. Lans 4342' Marm. 4972'
 DST 4982-5041 open 45 min rec 310' MSt
 1390# Cherokee 5160' Morrow sh 5467'
 Morrow sd 5489'
 DST 5460-5554, open 1 hr. rec 15' drlg
 mud. 70#. Chester 5567'
 DST 5552-5607 open 1 hr rec 7' mud
 90#. DST 5603-5704, open 50 min,
 rec 5' mud 90#.
 DST 5709-85 open 45 min rec 3' mud
 90#. St. Gen. 5779'
 DST 5785-5861 open 1 hr. rec 8' mud
 69# TD 5861' 5" @ 5753 CO to 5711'
 36/5616-22 1000 A dry PB 5612
 72/5597-5609 SP 5594 60/5583-93
 1000 A.
 Schl tops: Hol. 2574', Her. 2634',
 Kri. 2660', Win. 2742', Top 3873',
 Heeb 4228', Tor. 4244', Lans 4336',
 Marm. 4962', Cherokee 5154',
 Morrow zone 5467', Morrow sd 5495'

1955
2/16

(Information continued)

Chester 5564', St. Gen. 5740'
CO to 5578', 36/5568-74 A-frac.
S/12 GOPH 13 hr. Hydro.
S/20 GOPH 15 hr. PB 5567'
40/5557-65, 20 goph, sd-oil-frac.
S/7 GO 34 GWPH PB 2767 24/2744-52
500 A S/134 GWPH 10 hr. PB 2734
36/2700-06 72/2710-22 5500 A
1,800,000 CFG. SP 2693'
108/2662-80 A-frac. CO to 2730
2,062,000 CFG 45 GWPH
Comp. 5,700,000 CFGPD 385#

COMPLETED

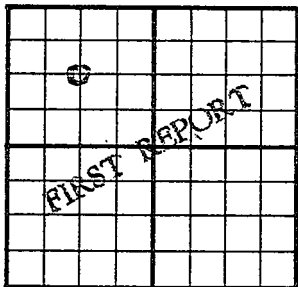County Seward State KansasSec. 34 (Blk.) 31S (Sur.) 32W Map No.Operator Shelly Oil Co.Well No. 1 Farm C. S. HighElev. Location C NW/41320 Ft. From N Line1320 Ft. From W Line NW Quarter1st. Report DEC 8 1954

Completion

Remarks Nye & Snell tools?

Spudding Date

Drlg. Data

Loc.


FABEN GILSTRAP

1. CG. <i>MM</i>
2. Serial No.
3. <i>33</i>
4. Date
5. Place
6. Misc.

DEC 10 1954

Orig. Data

County Seward State Kansas
 Sec. 34 (Blk. 31) (Sir. 32W) (Twp. Map No.)
 Operator Skelly Oil
 Well No. 1 Farm C. S. High
 Elev. 2850 Location C NW/4

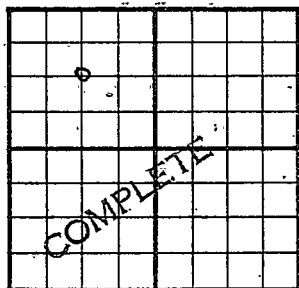

1320 Ft. From N Line NW
1320 Ft. From W Line Quarter

1st. Report

Completion FEB 1 6 1955

Remarks

Nye & Snell - Contr.

Spudding Date 12-7-54

Drlg. Data Gas well TD 5861

8" @ 715 Her. 2634 Kri. 2660

Win. 2742 Tow. 2790 Ft. Riley 2852

DST 4353-73 open 1 hr. Rec. 105' mud

& sw 1100# Lans. 4342 Marm. 4972

DST 4982-5041 open 45 min. Rec. 310'

msw 1390# Cherokee 5160

Morrow sh. 5467 Morrow sd. 5489

DST 5460-5554 open 1 hr. Rec. 15' drlg.

mud 70# Chester 5567 DST 5552-5607

open 1 hr. Rec. 7' mud 90# DST 5603-

5704 open 50 min. Rec. 5' mud 90#

DST 5709-85 open 45 min. Rec. 3' mud

90# St. Gen. 5779 DST 5785-5861

open 1 hr. Rec. 8' mud 69# TD 5861

FABEN GILSTRAP OVER

Dir. Data

MISC

5" @ 5753

CO to

5711

36/

5616-22

5597-5609

1000 A dry

PB 5612

72/

5597-5609

SP 5594

60/

5582-95

1000 A


SCHUMBERGER TOPS:

Small

Map



Hol. 2874

Heb.

2634



Win. 2742

Top.

3873

Heeb. 4228


Tor. 4244

Lans.

4336

Marm. 4962


Cherokee 5154

Morrow zone

5467



Morrow sd. 5495

-

Chester 5564

St. Gen.


5740

CO to

5578

36/

5568-74

S/ 12 goph

13 hr.

Hydro.

S/ 20 goph


15 hr.

PB 5567

40/

5557-65


sd-oil-frac

S/ 7

eo 34

rwph

PB 2767

24/ 2744-52

500 A

S/ 134

rwph

10 hr.

PB 2734

36/

2700-06

72/

2710-22

5500 A

1,800,000

cfr

SP 22693


108/ 2662-80

A-frac

CO to

2730


2,062,000

cfr

45

rwph


Comp. 5,700,000

cfrpd

385#


