

Barber


KANSAS

SECTION 31 TOWNSHIP 31 RANGE 14 W

WELL NO. #1 Mills

COMPANY Jones, Shelburne & Farmer

NORTH

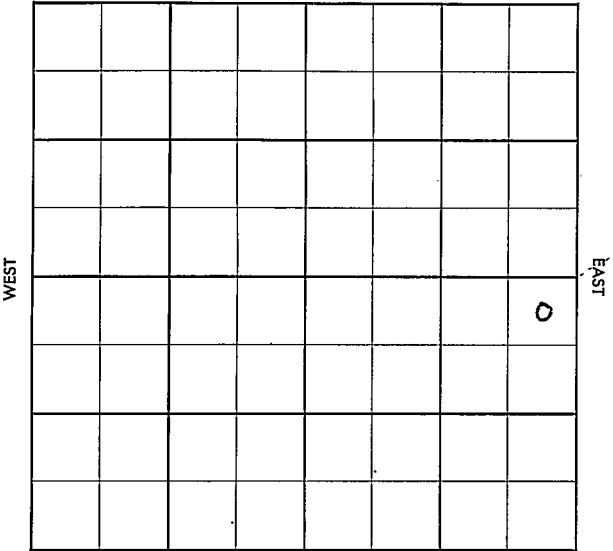

SOUTH

SEC. 34	TWP. 31	R. 14W
------------	------------	-----------

WELL NO. #1 Mills FARM

COMPANY Jones, Shelburne & Farmer

CONTRACTOR D & M Drlg.


WILDCAT

_____ Ft. from N. Line

_____ Ft. from S. Line

_____ Ft. from E. Line

_____ Ft. from W. Line

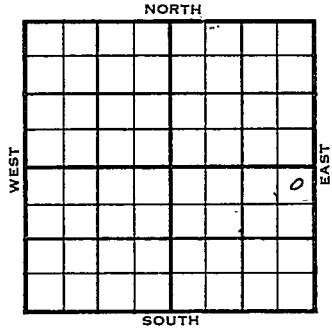

NE NE SE

Gulf- DHM

1955	ELEVATION 1700'	REPORT
------	--------------------	--------

11-30 Comm. 11-23-55
8" @ 205/150
Drlg. 2865'

12-21 DST 3861-67 op 1 hr. rec. 90' mw, 90' GIP, 1190#
DST 4553-63 op 1 hr. rec. 20' mud, 0#
DST 4766-78 op 1 1/2 hr. rec. 240' GIP
32' o&mo, 30' ocm, 120' so&gcmw,
1460/20"
D & A
Elg. 3734
Dg. Sd. 3860
L. 3955
Marm 4314
M. 4396
V. 4550
S. 4680
A. 4764
TD 4783'

ABANDONED

County Barber Elev. _____
 Sec. 34 Twp. 31 Rgs. 11W
 Company Jones, Shelburne & Farmer
 FarmName Mills No. 1

TOPS	DEPTH	LOG	DATUM	Loc. in Sec.
Anh.				NE NE SE
Tp.				
H.				
Tr.				
Dg.				
Bl.				
L.				
K.C.				Geol. _____
B.K.C.				Contr. _____
Ce.				<u>D & M Drlg.</u>
C.				
M.				Pool _____
M.				<u>Wildcat</u>
K.				
Mz.				
Me.				
V.				
S.				
S.				
A.				
R.				
Pe.				
G.				
T.D.				

FIRST REPORT
 NOV 30 55

Date Comm. 11-23-55 Gulf - DHM
8" @ 205/150 drlg. 2865

21/6

Co.
 Loc.
 No.
 Sec.
 T.
 R.

County **Barber** Elev. **1700**
 Sec. **31** Twp. **31** Rge. **14W**
 Company **Jones, Shelburne & Farmer**
 FarmName **Mills** No. **1**

TOPS	DEPTH	LOG	DATUM	Loc. in Sec.																												
Anh.				NE NE SE																												
Tr.																																
Dg.																																
Bl.																																
L.	3955		2255	Geol.																												
K.C. <i>Marm</i>	4314		3614																													
B.K.C.				Contr.																												
Ce.																																
C.				D & M Drlg.																												
M.	4396		2696																													
M.				Pool																												
K.																																
Mz.				Wildcat																												
Mq.																																
V.	4550		2850	<table border="1"> <tr><td></td><td></td><td></td><td></td></tr> <tr><td></td><td></td><td></td><td></td></tr> <tr><td></td><td></td><td></td><td></td></tr> <tr><td></td><td></td><td></td><td></td></tr> <tr><td></td><td></td><td></td><td></td></tr> <tr><td></td><td></td><td></td><td></td></tr> <tr><td></td><td></td><td></td><td></td></tr> </table>																												
S.	4680		2980																													
S.																																
A	4764		3064																													
R.																																
Pe.																																
G.																																
T.D.	4783																															

Date Comm. **11-23-55** DEC 21 1955
 8" @ 205/150 DST 3861-67 open 1 hr.
 rec. 90' mw 90' GIP 1190# DST 4553-63
 open 1 hr. rec. 20' mud 0#
 DST 4766-78 open 1 1/2 hr. rec. 240' GIP
 32' o & mo 30' ocm 120' so & gcmw
 1460/20"
 D & A.

Co.
Lse.
No.
Sec.
T.
R.