

DX 78-1

Summer

KANSAS

Section 34 Township 31 Range 1W

Well No. #1 Droll

Company Aladdin Pet.

NORTH

	0						

WEST

EAST

SOUTH

SEC.	TWP.	R.
34	31	1 W

WELL NO. # 1 Droll FARM

COMPANY Aladdin Pet.

CONTRACTOR Grove Drlg.

Wildcat


330 Ft. from N. Line

Ft. from S. Line

Ft. from E. Line

330 Ft. from W. Line

NW NW NW

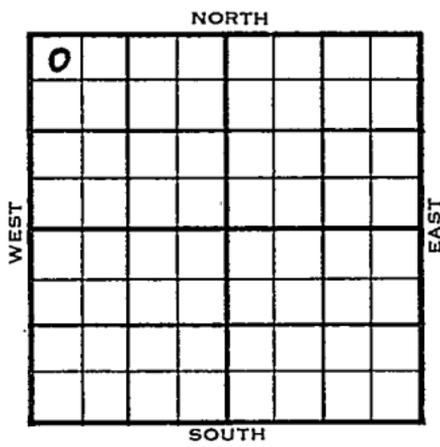

	ELEVATION	REPORT
1955	1274'	

3/2 Spud 2-25-55
8" @ 325

3/23 Drlg. 1085'
Spud 2-25-55, D&A; TD 4192
8" @ 325, KG 3037, Miss. 3661,
DST 3660-3710, failed,
DST 3665-3710, open 1/2 hr. Rec
5' drlg. mud 140#, Simp 4112,
DST 4112-22 open 1/2 hr, Rec
215' sw 1560# Arb 4183
TD 4192
E D&A

ABANDONED

County Sumner State Kansas

Sec. 34 (Blk. 31 (Sur. Rge.) 1W Map No.

Operator Aladdin Pet.

Well No. 1 Farm Droll

Elev. Location NWNW NW

0							

330 Ft. From N Line NW

330 Ft. From W Line Quarter

1st. Report MAR 2 1955

Completion

Remarks

Crowe Drlg. - Contr.

Spudding Date 2-25-55

Drlg. Data Wildcat

8" @ 325 drlg. 1085

FABEN GILSTRAP

Scout Cards

MM

Land Small Map

Land Wall Map

BR

Treasures

Orange Map

Pierce Map

Misc.

MAR 8

1955

Drig. Data

County Sumner State Kansas

Sec. 34 (Blk. 31 (Sur. 1W (Twp. Rge.) Map No.

Operator Aladdin Pet.

Well No. 1 Farm Droll

Elev. 1274 Location NW NWNW

0				

330 Ft. From N Line NW

330 Ft. From W Line Quarter

1st. Report

Completion MAR 23 1955

Remarks Wildeat

Crowe Drlg. - Contr.

Spudding Date 2-25-55

Drlg. Data D & A TD 4192

8" @ 325 KC 3037 Miss. 3661

DST 3660-3710 failed DST 3665-3710

open 1/2 hr. Rec. 5' drlg. mud 140#

Simp. 4112 DST 4112-22 open 1/2 hr.

Rec. 215' sw 1560# Arb. 4183

TD 4192

D & A

FABEN GILSTRAP

_____	Misc.
_____	Pierce Map
_____	France Map
_____	Trainers
_____	Land Wall Map
_____	Land Small Map
_____	Scout Cards

mmms

MAR 31 1955